

OREGON CORNER RESTORATION FORM

N-7

Section 17 Township 4S Range 25E
 County Morrow Date: May 4, 1998

Corner Designation: 4S25N7

1/4 corner common to sections 17 and 20,
 T4S, R25E, W.M.


Condition Report Only
 Not found
 Remonumented
 Unrecorded
 Surveyed in
 Referenced out

Previous Renewals / Surveys, etc.


The corner was originally established by Zenas F. Moody under contract No. 184,
 dated August 16, 1873. His record reads "Set stone 14x10x9 for 1/4 S. Cor."

Monument and Accessories found: (condition and source)

Found a mound of stone in a grassy swale at the head of a draw. There were no
 stones of record dimension in the mound. There was no other stone of any size
 within 150 feet of the mound.

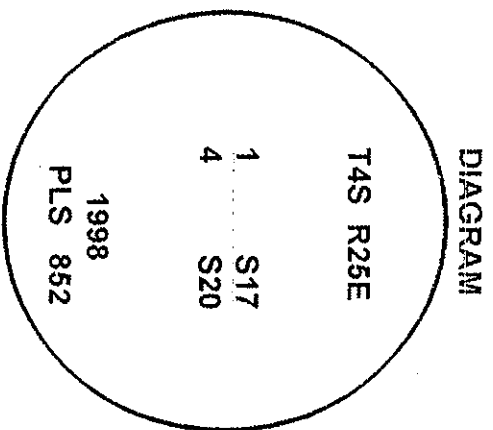

DIAGRAM

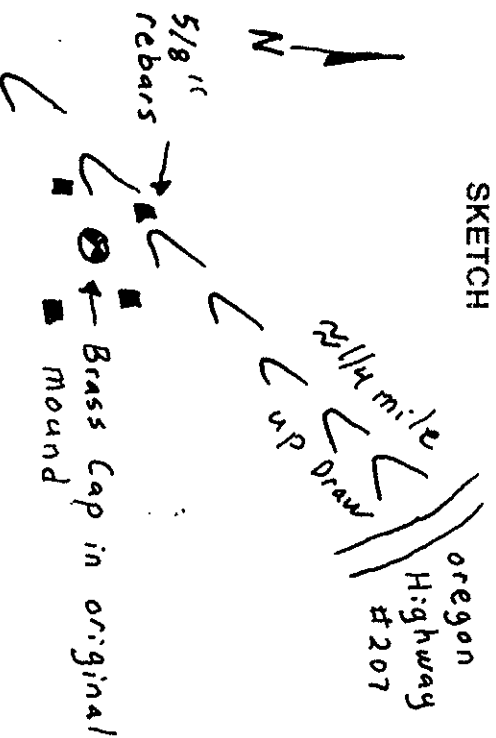

SKETCH

MONUMENT (S) AND ACCESSORIES SET (Procedures and Description)

Set a 2 1/4 inch brass cap on a 1 1/8" x 1" galvanized iron pipe stamped as shown in the
 diagram above in the mound of stone.

REFERENCES SET:

- A 5/8" x 24" rebar with a 1 1/8 inch red plastic cap stamped ORLS 852 and WALLS 13922
 bears N54°45'01"W a distance of 32.36 feet.
- A 5/8" x 24" rebar with a 1 1/8 inch red plastic cap stamped ORLS 852 and WALLS 13922
 bears N21°18'49"E a distance of 29.20 feet.
- A 5/8" x 24" rebar with a 1 1/8 inch red plastic cap stamped ORLS 852 and WALLS 13922
 bears S55°54'11"E a distance of 30.19 feet.
- A 5/8" x 24" rebar with a 1 1/8 inch red plastic cap stamped ORLS 852 and WALLS 13922
 bears S50°41'01"W a distance of 25.44 feet.

Location and comments
 Monument and references
 located using GPS.

Compass Declination

Surveyors Seal

Firm / Agency
 Haddock Surveying
 Address
 P.O. Box 1574
 Pendleton, Or. 97801
 Party Chief
 Stephen K, Haddock

RECEIVED BY:
 Morrow County Surveyor
 Date:
 Rec'd By:
 No.



David L. Haddock

