

OREGON CORNER RESTORATION FORM


Section 19 Township 4S Range 25E
 County Morrow Date: April 24, 1999

Corner Designation: 4S25P1

quarter corner to section 19, R25E, and _____ X _____ Remonumented
 section 24, R24E of T4S, W.M., Morrow County, Oregon _____ X _____ Unrecorded
 _____ X _____ Surveyed in
 _____ X _____ Referenced out

Previous Renewals / Surveys, etc.
 Corner originally set by Zenas F. Moody under contract No. 184 Dated March 29, 1873.
 His record reads: Set stone 14x12x10 for 1/4 sec. cor.

Monument and Accessories found: (condition and source)
 Found a fence intersection with fences running east, west, and south. The fence to the south could be seen to extend for several miles. The distance to this point from the 1/4 stone 1 mile to the north agreed very well with other checks between monuments set under this same contract.

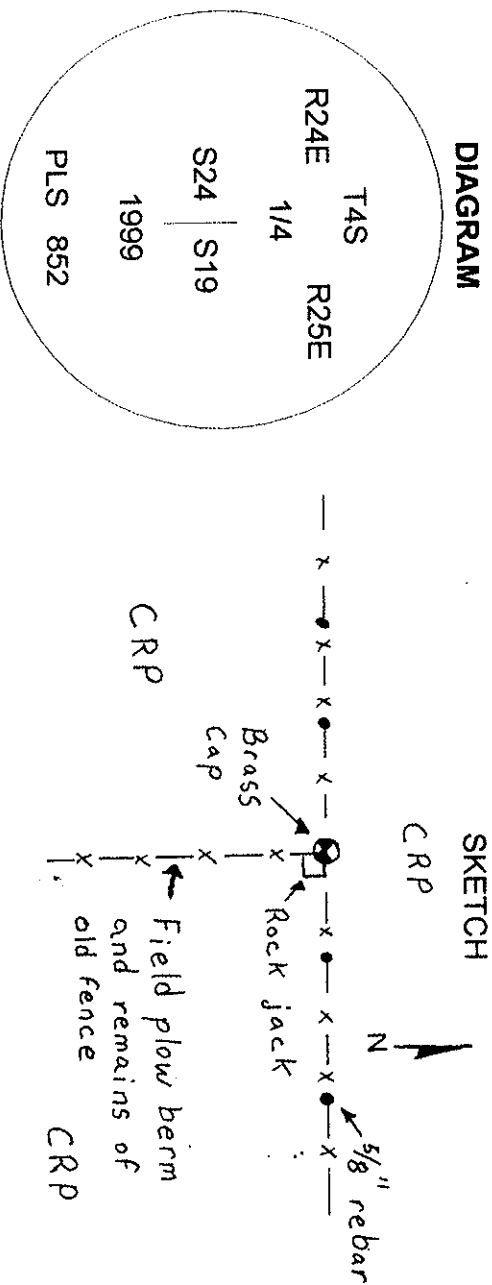

MONUMENT (S) AND ACCESSORIES SET (Procedures and Description)
 Set a 1 1/4" x 30" Galvanized Iron Pipe with a 2 1/2" brass cap stamped a shown in the diagram above at the position of the fence intersection. The cap is buried full depth in the soil and lies on the northwest edge of a mound of stone approximately 3' across that is the remains of a decayed rock jack. There were several stones in the jack that were record dimension.

For references, I set four 5/8" by 24" rebars with 1.25" red plastic caps stamped ORLS 852 and WALIS 13922 as described below:
 an iron rebar bears N89°18'W, 34.86 feet under the existing fence;
 an iron rebar bears N89°37'W, 72.88 feet under the existing fence;
 an iron rebar bears N88°31'E, 32.24 feet under the existing fence;
 an iron rebar bears N88°33'E, 71.86 feet under the existing fence;

The monument and references were tied using a LIECA system 300 RTK GPS.

Location and comments

Compass Declination

Surveyors Seal

RECEIVED BY:
 Morrow County Surveyor
 Date:
 Rec'd By:
 No.

Firm / Agency
 Haddock Surveying
 Address
 P. O. Box 1574
 Pendleton, Or. 97801
 Party Chief
 Stephen K, Haddock

