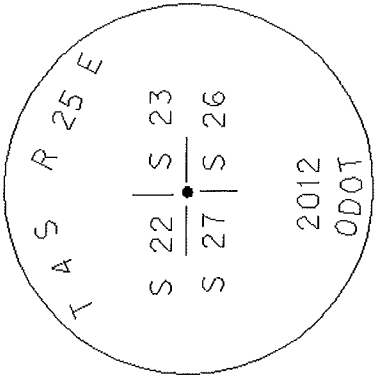
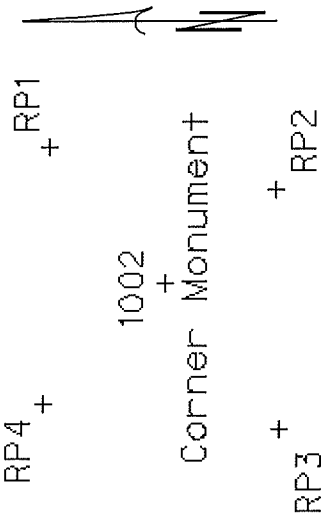
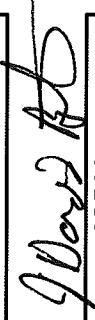


R-17

OREGON PUBLIC LAND CORNER REPORT / RESTORATION REPORT
MORROW COUNTY SURVEYOR'S OFFICE

SECTION 27	TOWNSHIP 4 S.	RANGE 25 E.	DATE June, 2012
MORROW COUNTY			
CORNER DESIGNATION: 4S25R17			
<div style="display: flex; justify-content: space-between;"> <div style="width: 45%;"> <p><i>Previous Renewals / Surveys, etc.</i></p> <p>Originally set by Zenas F Moody under contract No. 184, dated March 29, 1873. He set a stone 20x18x16 for the corner to Sections 22, 23, 26 and 27.</p> </div> <div style="width: 45%;"> <p><i>Monument(s) & Accessories Found: (Condition & Source)</i></p> <p>Found stone of near record size in the center of a mound or ring of stone. No marks are visible.</p> </div> </div>			
<div style="display: flex; justify-content: space-between;"> <div style="width: 45%;"> <p><i>Monument Detail:</i></p>  </div> <div style="width: 45%;"> <p><i>Sketch:</i></p>  </div> </div>			
<p><i>Monument Set (Procedures and Description):</i></p> <p>Set 1"x36" galvanized iron pipe with a 2-1/2" Brass Cap stamped as shown above, 18" in the ground and raised a mound of stone around it. Buried the record stone along side the pipe.</p>			
<p><i>New Accessories:</i></p> <p>Set four 5/8"x20" iron rods with 2" Aluminum Caps stamped Oregon Dept. of Transportation. The monument and references were ties using Leica System 1200 RTK GPS. Bearings and distances to corner as follows: RP1 - N49-47°E, 11.64 Feet, RP2 - S40-20°E, 9.32 Feet, RP3 - S51-45°W, 11.71 Feet, RP4 - N44-41°W, 10.96 Feet</p>			
<p><i>Location & Comments:</i></p>			
<p><i>Firm / Agency</i></p> <p>Oregon Department of Transportation, Geometrics Unit</p>			
<p><i>Party Chief</i></p> <p>J. David Brinton, PLS</p>			
<p><i>Notes</i></p>			
<p><i>Witness</i></p> <p>Bill Dye, PLS</p>			
<p>SURVEYOR'S SEAL</p> <div style="border: 1px solid black; padding: 5px; display: inline-block;"> REGISTERED PROFESSIONAL LAND SURVEYOR  </div> <div style="border: 1px solid black; padding: 5px; display: inline-block; margin-top: 5px;"> OREGON December 2, 1983 J. David Brinton 2065 </div> <div style="border: 1px solid black; padding: 5px; display: inline-block; margin-top: 5px; width: 100px;"> RENEWAL DATE: 12/31/13 </div>			