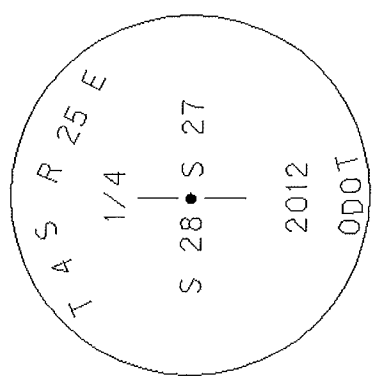
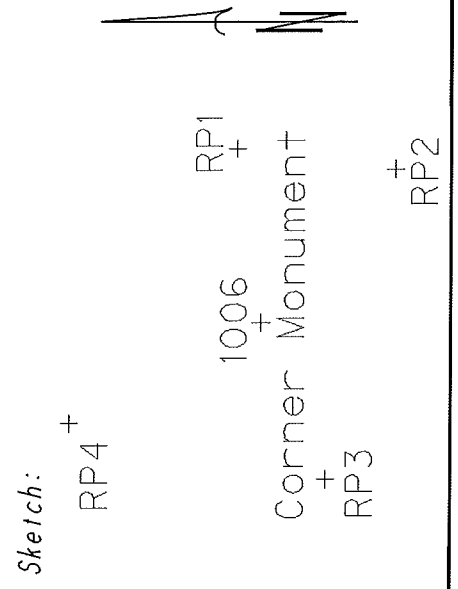
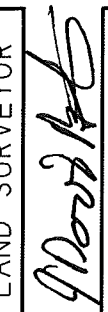


T13

OREGON PUBLIC LAND CORNER REPORT / RESTORATION REPORT
MORROW COUNTY SURVEYOR'S OFFICE

SECTION 27	TOWNSHIP 4 S.	RANGE 25 E.
MORROW COUNTY		DATE June, 2012
CORNER DESIGNATION:		
(Please check one)		
<input type="checkbox"/> Condition Report Only		
<input type="checkbox"/> Not Found		
<input checked="" type="checkbox"/> Renewed		
<input type="checkbox"/> Unrecorded		
<input type="checkbox"/> Surveyed In		
<input type="checkbox"/> Referenced Out		
<p><i>Previous Renewals / Surveys. etc.</i></p> <p>Originally set by Zenas F Moody under contract No. 184, dated March 29, 1873. He set a stone 14x12x7 for the West 1/4 corner to Section27.</p>		
<p><i>Monument(s) & Accessories Found: (Condition & Source)</i></p> <p>Found a stone of record size in a mound of stone.</p>		
<p><i>Monument Detail:</i></p> 	<p><i>Sketch:</i></p> 	
<p><i>Monument Set (Procedures and Description):</i></p> <p>Set 1"x36" galvanized iron pipe with a 2-1/2" Brass Cap stamped as shown above, 26" in the ground and raised a mound of stone around it.</p>		
<p><i>New Accessories:</i></p> <p>Set four 5/8"x20" iron rods with 2" Aluminum Caps stamped Oregon Dept. of Transportation. The monument and references were ties using Leica System 1200 RTK GPS. Bearings and distances to corner as follows: RP1 - N82-22'E, 12.19 Feet, RP2 - S49-00'E, 11.76 Feet, RP3 - S67-29'W, 9.73 Feet, RP4 - N27-44'W, 12.40 Feet</p>		
<i>Location & Comments:</i>		
<i>Compass Declination:</i>		
<i>Firm / Agency</i>		
Oregon Department of Transportation, Geometrics Unit <input checked="" type="checkbox"/>		
<i>Party Chief</i>		
J. David Brinton, PLS		
<i>Notes</i>		
Bill Dye, PLS		
<p>SURVEYOR'S SEAL</p> <div style="border: 1px solid black; padding: 5px; display: inline-block;"> REGISTERED PROFESSIONAL LAND SURVEYOR </div>  <div style="border: 1px solid black; padding: 5px; display: inline-block;"> OREGON December 2, 1983 J. David Brinton 2065 </div> <div style="border: 1px solid black; padding: 5px; display: inline-block;"> RENEWAL DATE: 12/31/13 </div>		