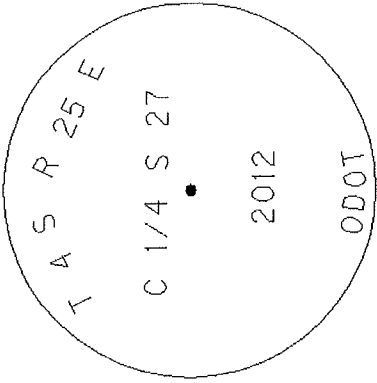
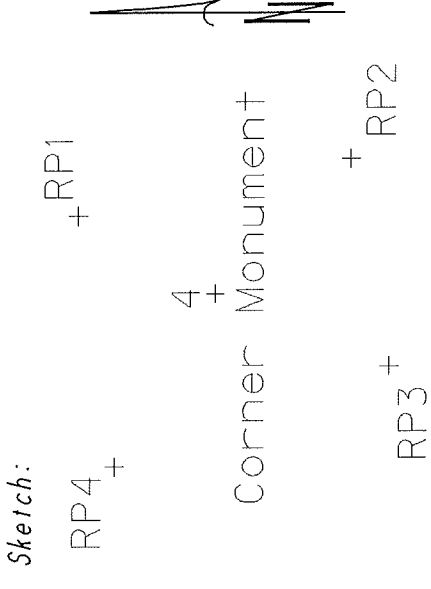


T-15

OREGON PUBLIC LAND CORNER REPORT / RESTORATION REPORT

MORROW COUNTY SURVEYOR'S OFFICE

SECTION 27	TOWNSHIP 4 S.	RANGE 25 E.	DATE June, 2012
MORROW COUNTY			
CORNER DESIGNATION:			
(Please check one)			
<input type="checkbox"/> Condition Report Only			
<input type="checkbox"/> Not Found			
<input type="checkbox"/> Renewed			
<input type="checkbox"/> Unrecorded			
<input checked="" type="checkbox"/> Surveyed In			
<input type="checkbox"/> Referenced Out			
4S25T15			
Previous Renewals / Surveys. etc. None.			
Monument(s) & Accessories Found: (Condition & Source) NA			
Monument Detail: 	Sketch: 		
Monument Set (Procedures and Description): Set 1"x36" galvanized iron pipe with a 2-1/2" Brass Cap stamped as shown above, 26" in the ground and raised a mound of stone around it.			
New Accessories: Set four 5/8"x20" iron rods with 2" Aluminum Caps stamped Oregon Dept. of Transportation. The monument and references were ties using Leica System 1200 RTK GPS. Bearings and distances to corner as follows: RP1 - N49-43'E, 8.56 Feet, RP2 - S44-34'E, 10.43 Feet, RP3 - S22-33'W, 10.28 Feet, RP4 - N59-50'W, 10.88 Feet			
Location & Comments:		Compass Declination:	
Firm / Agency Oregon Department of Transportation, Geometrics Unit			
Party Chief J. David Brinton, PLS			
Notes			
Witness Bill Dye, PLS			

SURVEYOR'S SEAL

REGISTERED
 PROFESSIONAL
 LAND SURVEYOR

J. David Brinton

OREGON
 December 2, 1983
 J. David Brinton
 2065

RENEWAL DATE: 12/31/13