

T-19

OREGON PUBLIC LAND CORNER REPORT / RESTORATION REPORT

MORROW COUNTY SURVEYOR'S OFFICE

SECTION 27	TOWNSHIP 4 S.	RANGE 25 E.
MORROW COUNTY		DATE June, 2012
CORNER DESIGNATION: 4S25T17		
(Please check one)		
<input type="checkbox"/> Condition Report Only		
<input checked="" type="checkbox"/> Not Found		
<input type="checkbox"/> Renewed		
<input type="checkbox"/> Unrecorded		
<input type="checkbox"/> Surveyed In		
<input type="checkbox"/> Referenced Out		


Previous Renewals / Surveys. etc.

Originally set by Zenas F Moody under contract No. 184, dated March 29, 1873. He set a stone 14x10x7 for the East 1/4 corner to Section 27.


Monument(s) & Accessories Found: (Condition & Source)

No evidence of the original corner found.

Monument Detail:

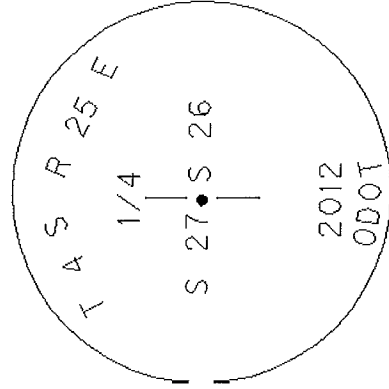

Sketch:

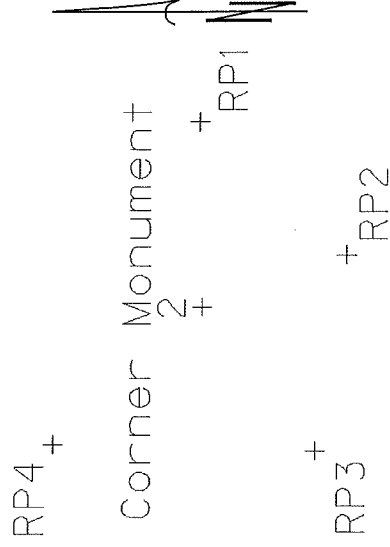

Monument Set (Procedures and Description):

Set 1"x36" galvanized iron pipe with a 2-1/2" Brass Cap stamped as shown above, 26" in the ground and raised a mound of stone around it. Corner was set at single proportionate measure.

New Accessories:

Set four 5/8"x20" iron rods with 2" Aluminum Caps stamped Oregon Dept. of Transportation. The monument and references were ties using Leica System 1200 RTK GPS. Bearings and distances to corner as follows:

RP1 - N89-12°E, 9.92 Feet, RP2 - S19-42°E, 8.26 Feet, RP3 - S45-12°W, 8.20 Feet, RP4 - N42-28°W, 10.95 Feet

Location & Comments:

Compass Declination:

Firm / Agency

SURVEYOR'S SEAL

Oregon Department of Transportation, Geometrics Unit

REGISTERED PROFESSIONAL LAND SURVEYOR

Party Chief

J. David Brinton, PLS

J. David Brinton

Notes

OREGON
December 2, 1983
J. David Brinton
2065

Witness

Bill Dye, PLS

RENEWAL DATE: 12/31/13