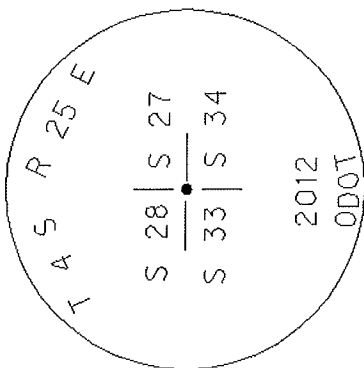
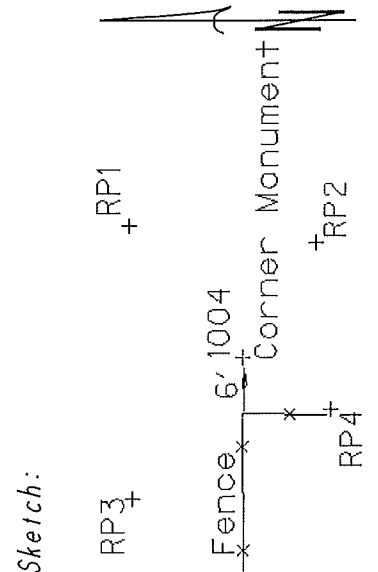



V-13

# OREGON PUBLIC LAND CORNER REPORT / RESTORATION REPORT

MORROW COUNTY SURVEYOR'S OFFICE

<b>SECTION</b> 27	<b>TOWNSHIP</b> 4 S.	<b>RANGE</b> 25 E.
<b>MORROW COUNTY</b>		<b>DATE</b> June, 2012
<b>CORNER DESIGNATION:</b>		
(Please check one)		
<input type="checkbox"/> Condition Report Only		
<input type="checkbox"/> Not Found		
<input checked="" type="checkbox"/> Renewed		
<input type="checkbox"/> Unrecorded		
<input type="checkbox"/> Surveyed In		
<input type="checkbox"/> Referenced Out		
<p><b>4S25V13</b></p> <p><i>Previous Renewals / Surveys. etc.</i></p> <p>Originally set by Zenas F Moody under contract No. 184, dated March 29, 1873. He set a stone 12x11x9 for the corner to Sections 33, 34, 27 and 28.</p>		
<p><i>Monument(s) &amp; Accessories Found: (Condition &amp; Source)</i></p> <p>Found a mound of stone 6 feet East of a fence corner. The record size stone probably was used in the nearby rock jack. No other stone was found nearby except the mound which was accepted as the corner position.</p>		
<p><i>Monument Detail:</i></p> 	<p><i>Sketch:</i></p> 	
<p><i>Monument Set (Procedures and Description):</i></p> <p>Set 1"x36" galvanized iron pipe with a 2-1/2" Brass Cap stamped as shown above, 30" in the ground and raised a mound of stone around it.</p>		
<p><i>New Accessories:</i></p> <p>Set four 5/8"x20" iron rods with 2" Aluminum Caps stamped Oregon Dept. of Transportation. The monument and references were ties using Leica System 1200 RTK GPS. Bearings and distances to corner as follows:          RP1 - N43-13'E, 12.19 Feet, RP2 - S57-35'E, 9.56 Feet, RP3 - N52-19'W, 12.61 Feet, RP4 - S30-34'W, 7.21 Feet</p>		
<i>Location &amp; Comments:</i>		<i>Compass Declination:</i>
<i>Firm / Agency</i>		
Oregon Department of Transportation, Geometrics Unit		
<i>Party Chief</i>		
J. David Brinton, PLS		
<i>Notes</i>		
Bill Dye, PLS		
<b>SURVEYOR'S SEAL</b>		
REGISTERED PROFESSIONAL LAND SURVEYOR		
		
OREGON December 2, 1983 J. David Brinton 2065		
		RENEWAL DATE: 12/31/13