


CERTIFIED RECORD OF LAND CORNER MONUMENTATION

U.S.F.S. INDEX No. F-3

History of original corner establishment: This corner was not originally established.

DIAGRAM

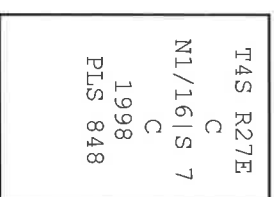

Description of Corner Evidence Found:

This corner was not originally established.

Description of monument and accessories I established to perpetuate the original location of this corner:

Set a 5/8"x30" iron pin with a 1-1/2" aluminum cap, stamped as shown in DIAGRAM, 26" in the ground,

From which:

Set a 5/8"x30" iron pins with plastic caps stamped PLS 848 at the following bearings and distances:

N63°48'W, 25.18 ft., in an east-west fence.

N69°12'E, 27.55 ft., in an east-west fence.


Measurements to accessories taken with a Wild TCI600 Total Station

This work was performed by:

Douglas M. Ferguson, PLS 848

Witnessed by: D. Mitchell Ferguson
and Brad Cates

Date: 4-19-98

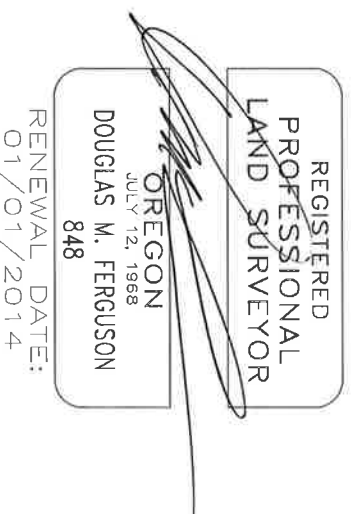

Office of Surveyor, County of Morrow, State of Oregon,
I hereby certify that the within instrument was
filed in this office for record on the 23 day of August, 2013

[Signature]
(COUNTY OFFICIAL)

by _____
(DEPUTY)

Refer to Morrow County Map No. 2013-34D