


**CERTIFIED RECORD OF LAND CORNER MONUMENTATION**

U.S.F.S. INDEX No. G-1

**History of original corner establishment:** This corner was originally established by Zenas F. Moody in 1873, under GIO Contract No. 184.

**DIAGRAM**

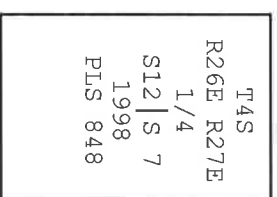

Surveyor General Field Notes State:

Set stone 10x10x6 for 1/4 sec. cor.

**Description of Corner Evidence Found:**

No original corner evidence found. Set a proportionate measure from the corners 1/2 mile north and 1/2 mile south.

**Description of monument and accessories I established to perpetuate the original location of this corner:**

At the proportionate position, Set a 2-1/2"x30" aluminum pipe with 2-1/2" aluminum cap, stamped as shown in DIAGRAM, 25" in the ground.


From which:

Set a 5/8"x30" iron pins with plastic caps stamped PLS 848 at the following bearings and distances:

- N51°W, 9.2 ft.
- N39°E, 8.8 ft., one groove in top of pin.
- S51°E, 9.8 ft., two grooves in top of pin.
- S42°W, 10.0 ft., three grooves in top of pin.

Measurements to accessories taken with a magnetic compass, declination 17° east, and a nylon clad steel tape.

This work was performed by:  
Douglas M. Ferguson, PLS 848  
Witnessed by: D. Mitchell Ferguson  
and Brad Cates  
Date: 4-20-98

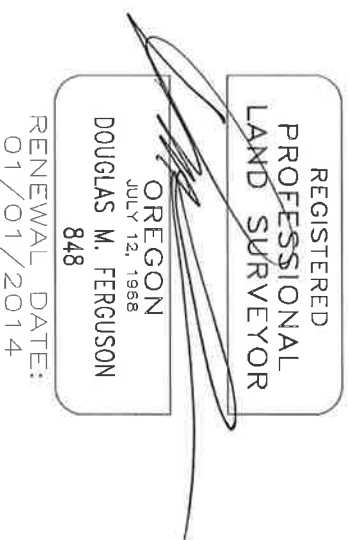

Office of Surveyor, County of Morrow, State of Oregon,  
I hereby certify that the within instrument was  
filed in this office for record on the 23 day of August, 2013

Dylan K. Wood by \_\_\_\_\_  
(COUNTY OFFICIAL) (DEPUTY)

Refer to Morrow County Map No. 2013-34D