


CERTIFIED RECORD OF LAND CORNER MONUMENTATION

U.S.F.S. INDEX No. G-5

History of original corner establishment: This corner was originally established by Zenas F. Moody in 1873, under GLO Contract No. 184.

DIAGRAM

Surveyor General Field Notes State:
Set stone 15x10x6 for 1/4 sec. cor.

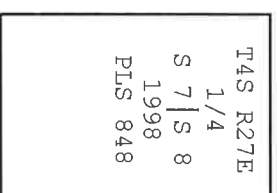

Description of Corner Evidence Found:

No original corner evidence found. Set a proportionate measure from the corners 1/2 mile north and 1/2 mile south.

Description of monument and accessories I established to perpetuate the original location of this corner:


At the proportionate position, Set a 2-1/2"x30" aluminum pipe with 2-1/2" aluminum cap, stamped as shown in DIAGRAM, 18" in the ground, raised a 2 ft. dia. by 8 in. high mound of stone around monument.

From which:

- Set a 5/8"x30" iron pins with plastic caps stamped PLS 848 at the following bearings and distances:
- N49°50'W, 24.82 ft., three grooves in top of pin.
 - N40°29'E, 25.34 ft., no grooves
 - S50°05'E, 25.53 ft., one groove in top of pin.
 - S41°36'W, 24.86 ft., two grooves in top of pin.

Measurements to accessories taken with a Wild TCI600 Total Station

This work was performed by:
Douglas M. Ferguson, PLS 848
Witnessed by: D. Mitchell Ferguson
and Brad Cates
Date: 4-19-98

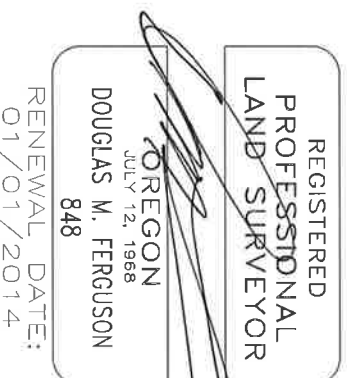

Office of Surveyor, County of Morrow, State of Oregon,
I hereby certify that the within instrument was
filed in this office for record on the 23 day of August, 2013

Stephen V. Plalbeck by _____
(COUNTY OFFICIAL) (DEPUTY)

Refer to Morrow County Map No. 2013-34D