


**CERTIFIED RECORD OF LAND CORNER MONUMENTATION**

U.S.F.S. INDEX No. J-1

**History of original corner establishment:** This corner was originally established by Zenas F. Moody in 1873, under GLO Contract No. 184.

**DIAGRAM**

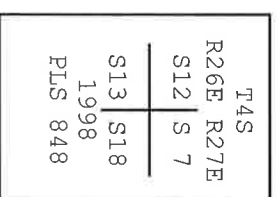

Surveyor General Field Notes State:

Set stone 18x12x8 in earth mound for the Cor to Secs. 12-13-7-18

**Description of Corner Evidence Found:**

Found a rock jack for an old south & east running fence line. Several stones of call size with no visible marks. No other stones or evidence in the area. Accepted rock jack as the best evidence of the original corner position.

**Description of monument and accessories I established to perpetuate the original location of this corner:**

At the center of the rock jack position, Set a 2-1/2"x30" aluminum pipe with 2-1/2" aluminum cap, stamped as shown in DIAGRAM, 20" in the ground, raised a 2-1/2 ft. dia by 1 ft. high mound of stone.


From which:

Set a 5/8"x30" iron pins with plastic caps stamped PLS 848 at the following bearings and distances:

- N47°W, 11.0 ft., no grooves
- N40°E, 10.6 ft., one groove in top of pin.
- S47°E, 13.1 ft., two grooves in top of pin.
- S41°W, 12.3 ft., three grooves in top of pin.

Measurements to accessories taken with a magnetic compass, declination 17° east, and a nylon clad steel tape.

This work was performed by:  
Douglas M. Ferguson, PLS 848  
Witnessed by: D. Mitchell Ferguson  
and Brad Cates  
Date: 4-20-98

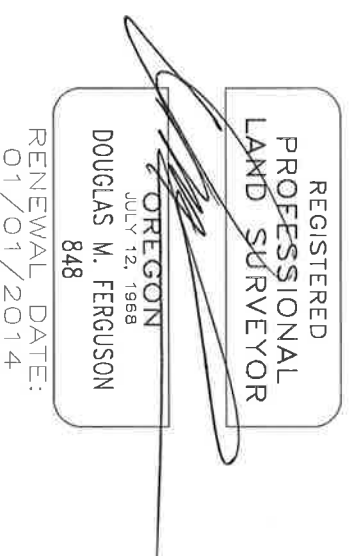

Office of Surveyor, County of Morrow, State of Oregon,  
I hereby certify that the within instrument was  
filed in this office for record on the 23 day of August, 2013

Brad K. Abbott by \_\_\_\_\_  
(COUNTY OFFICIAL) (DEPUTY)

Refer to Morrow County Map No. 2013-34D