


CERTIFIED RECORD OF LAND CORNER MONUMENTATION

U.S.F.S. INDEX No. J-5

History of original corner establishment: This corner was originally established by Zenas F. Moody in 1873, under GIO Contract No. 184.

DIAGRAM

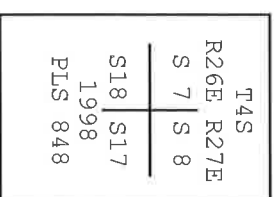

Surveyor General Field Notes State:

Set stone 24x16x12 in earth mound for Cor. to Secs 17-18-7-8

Description of Corner Evidence Found:

No original corner evidence found. Set a double proportionate measure from the corners 2 miles north, 1/2 mile south, 1 mile west and 1/2 mile east.

Description of monument and accessories I established to perpetuate the original location of this corner:

At the proportionate position, Set a 2-1/2"x30" aluminum pipe with 2-1/2" aluminum cap, stamped as shown in DIAGRAM, 10" in the ground, raised a 4 ft. dia. by 2 ft. high mound of stone.


From which:

Set a 5/8"x30" iron pins with plastic caps stamped PLS 848 at the following bearings and distances:

- N50°35'W, 26.06 ft., no grooves on pin, set in md. of stone.
- N39°15'E, 25.44 ft., one groove in top of pin, set in md. of stone.
- S52°41'E, 22.72 ft., two grooves in top of pin, set in md. of stone.
- S61°30'W, 21.27 ft., three grooves in top of pin, set in md. of stone.

Measurements to accessories taken with a Wild TC1600 Total Station

This work was performed by:
Douglas M. Ferguson, PLS 848
Witnessed by: D. Mitchell Ferguson
and Brad Cates
Date: 4-20-98

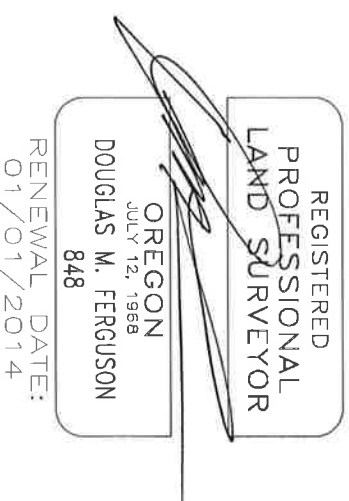

Office of Surveyor, County of Morrow, State of Oregon,
I hereby certify that the within instrument was
filed in this office for record on the 23 day of August, 2013

Steve K. Hubbard

by

(DEPUTY)

(COUNTY OFFICIAL)

Refer to Morrow County Map No. 2013-34D