


**CERTIFIED RECORD OF LAND CORNER MONUMENTATION**

U.S.F.S. INDEX No. J-9

**History of original corner establishment:** This corner was originally established by Zenas F. Moody in 1873, under GLO Contract No. 184.

**DIAGRAM**

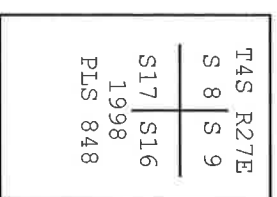

Surveyor General Field Notes State:

Set stone 24x16x10 in earth mound for Cor. to Secs 16-17-8-9

**Description of Corner Evidence Found:**

Found an old rock crib with a 20x15x9 stone in center. No other stones of call size in the area. Accepted the rock crib as the best evidence of the original corner position.

**Description of monument and accessories I established to perpetuate the original location of this corner:**

At the center of the rock crib, Set a 2-1/2"x30" aluminum pipe with 2-1/2" aluminum cap, stamped as shown in DIAGRAM, 24" in the ground, placed ring of stones around the monument.

From which:

Set a 5/8"x30" iron pins with plastic caps stamped PLS 848 at the following bearings and distances:

N48°57'W, 28.92 ft., no grooves.

N52°35'E, 38.47 ft., one groove in top of pin.

S36°16'E, 27.91 ft., two grooves in top of pin.

S58°47'W, 31.60 ft., three grooves in top of pin.


Measurements to accessories taken with a Wild TC1600 Total Station

This work was performed by:

Douglas M. Ferguson, PLS 848

Witnessed by: D. Mitchell Ferguson and Brad Cates

Date: 4-20-98

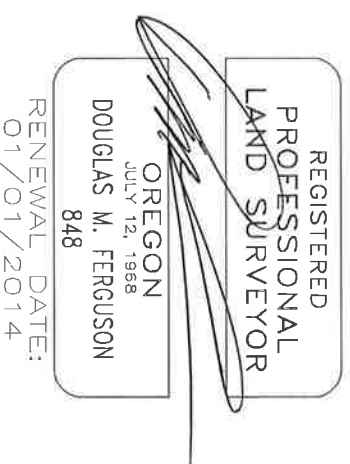

Office of Surveyor, County of Morrow, State of Oregon,  
I hereby certify that the within instrument was  
filed in this office for record on the 23 day of August, 2013

Steph K. Black by \_\_\_\_\_  
(COUNTY OFFICIAL) (DEPUTY)

Refer to Morrow County Map No. 2013-34D