

OREGON CORNER RESTORATION FORM

Section 2 Township 4S Range 28E  
 County Morrow Date: 23-Aug-21

Corner Designation: 4S28A17

Condition report only  
 Not Found  
 Remonumented  
 Unrecorded  
 Surveyed In  
 Referenced Out



North corner to Sections 2 and 3, T4S, R28E, W.M.,  
 Morrow County, Oregon.

Previous Renewals, Surveys, etc...

This corner was originally set by Frank W. Campbell under Contract No. 507, Dated June 28th, 1884. His record reads: Set a basalt stone 16x10x7 ins. for corner to Sec's 2 & 3, marked with 2 notches on E, 4 notches on W. and 6 notches on S. edges. Raised a mound of stone along side.

Monument and accessories found: (condition and source)

Found a basalt stone 16x10x7 inches clearly marked as described leaning downhill to the SE at the southerly edge of a mound of stone.

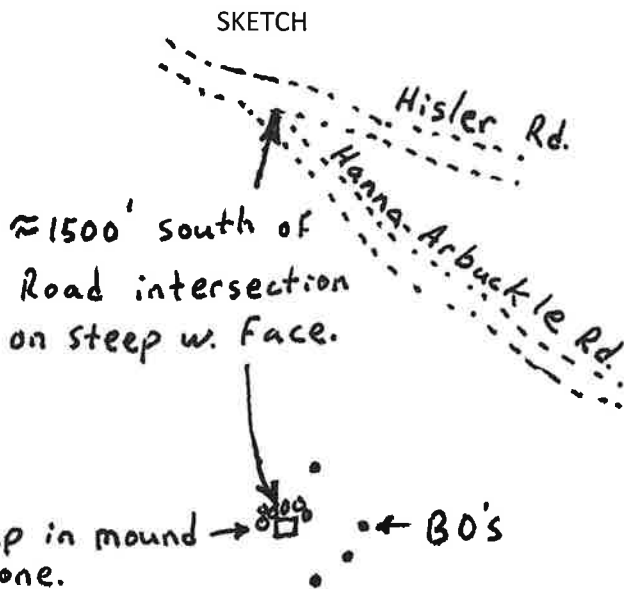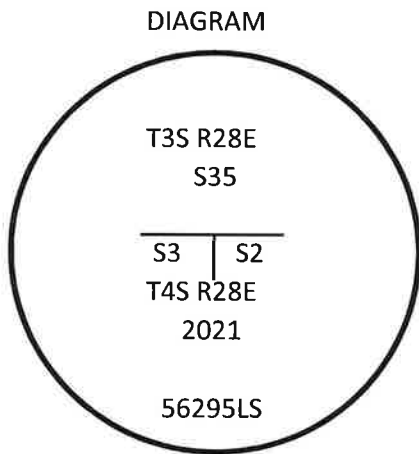

MONUMENT(S) AND ACCESSORIES SET (Procedures and Description)

At the position of the original stone I set a 1"x24" iron rebar with a 2" aluminum cap stamped as shown in the diagram above driven 18 inches to bedrock. I buried the original stone upside down on the east side of the rebar and add to the mound of stone on the southerly side of the original mound.

For references I set four 5/8" by 24" iron rebars with 1.25" orange plastic caps stamped WTS and 56295LS as described below:

- An iron rebar bears N6°04'26"E 37.25 feet;
- An iron rebar bears N81°41'12"E 46.84 feet;
- An iron rebar bears S71°28'47"E 31.02 feet;
- An iron rebar bears S18°28'52"E 39.90 feet;

Measurements were made with a Trimble R8S base/rover RTK GPS system.

Location and comments:

Approximate coordinate WGS84  
 Latitude = 45°15'19.56"N  
 Longitude = 119°18'37.82"W

RECEIVED BY:

Morrow County Surveyor  
 Date: 10-4-21  
 Rec'd By: MPK  
 No. 4S28A17

Compass Declination

Firm / Agency  
 Witness Tree Surveying  
 Address  
 P.O. Box G  
 Pilot Rock, OR 97868  
 Party Chief  
 Stephen K. Haddock

Surveyor's Seal

REGISTERED  
 PROFESSIONAL  
 LAND SURVEYOR

*Stephen K. Haddock*

OREGON  
 JULY 9, 2001  
 STEPHEN K. HADDOCK  
 56295LS

RENEWS: 6-30-23

SURVEY REF: 2021-1957D