

OREGON CORNER RESTORATION FORM

Section 2 Township 4S Range 28E  
 County Morrow Date: 23-Aug-21

Corner Designation: 4S28A21

Condition report only  
 Not Found  
 Remonumented  
 Unrecorded  
 Surveyed In  
 Referenced Out


North corner to Sections 1 and 2, T4S, R28E, W.M.,  
 Morrow County, Oregon.

Previous Renewals, Surveys, etc...

This corner was originally set by Frank W. Campbell under Contract No. 507, Dated June 28th, 1884. His record reads: Set a basalt stone 14x10x6 ins. for corner to Sec's 1 & 2, marked with 1 notch on E, 5 notches on W. and 6 notches on S. edges from which a pine, 24 ins in diam. Bears S60°E 183 lks dist marked T4S. R28E. S1 BT. A pine 36 ins in diam. Bears S38°W 220 lks dist. marked T4S, R28E, S2 BT.

Monument and accessories found: (condition and source)

Found a basalt stone 14x10x7 inches clearly marked as described at the NE corner of a fence corner rock jack with fence remains to the east and south. A 4"x4" aluminum location poster with the name "Heppner Lumber Co." was buried along side the stone. The original BT to Section 2 was dead and down lying on the open blaze.

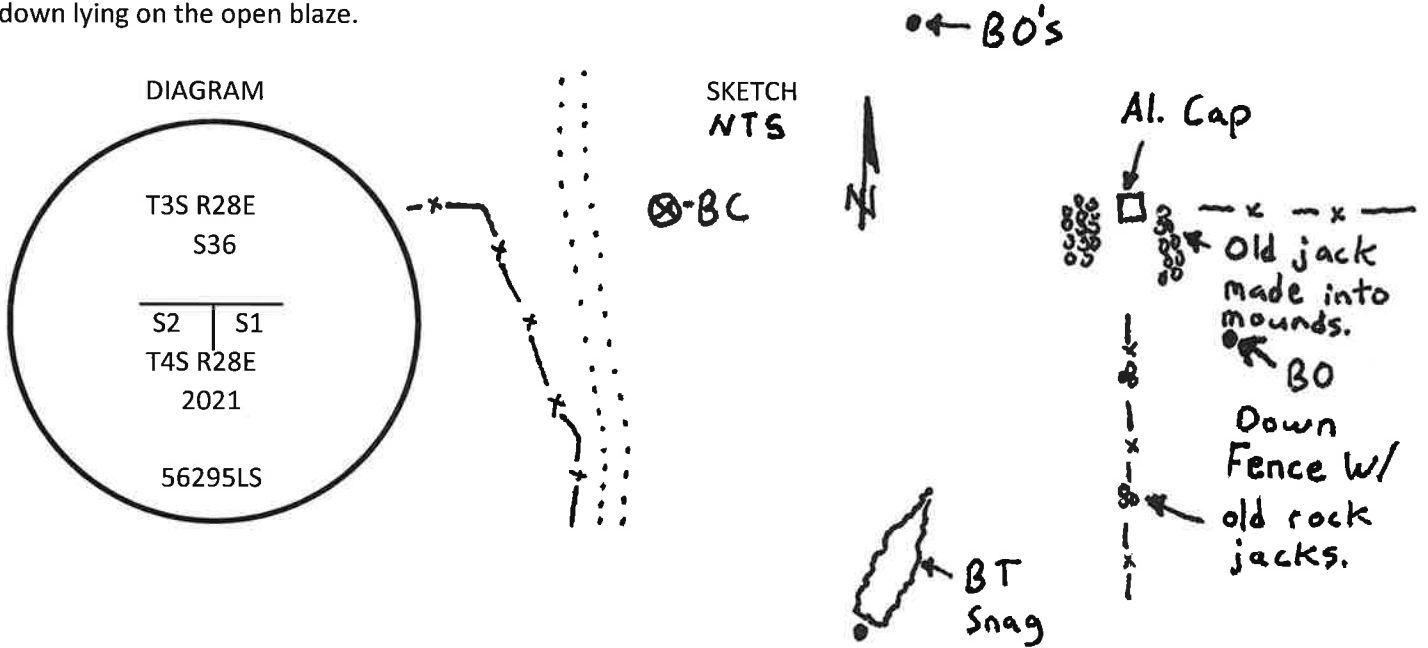

At the position of the original stone I set a 1"x24" iron rebar with a 2" aluminum cap stamped as shown in the diagram above. I buried the original stone upside down on the NE side of the rebar along with the location poster.

For references I set three 5/8" by 24" iron rebars with 1.25" orange plastic caps stamped WTS and 56295LS as described below:

- An iron rebar bears S28°39'50"E 54.37 feet;
- An iron rebar bears S37°12'24"W 147.11 feet in the root hole of the BT to Section 2;
- An iron rebar bears N53°11'48"W 225.83 feet;
- An 1/2" brass cap at the corner to T3S, R28E, Sections 35 & 36 bears N89°54'13"W 247.83 feet;

Measurements were made with a Trimble R8S base/rover RTK GPS system.

Location and comments:  
 Approximate coordinate WGS84  
 Latitude = 45°15'19.65"N  
 Longitude = 119°17'23.53"W  
 RECEIVED BY:  
 Morrow County Surveyor  
 Date: 10-4-21  
 Rec'd By: MPK  
 No. 4S28A21

Compass Declination  
 Firm / Agency  
 Witness Tree Surveying  
 Address  
 P.O. Box G  
 Pilot Rock, OR 97868  
 Party Chief  
 Stephen K. Haddock

Surveyor's Seal  
 REGISTERED PROFESSIONAL LAND SURVEYOR  
*Stephen K. Haddock*  
 OREGON  
 JULY 9, 2001  
 STEPHEN K. HADDOCK  
 56295LS

SURVEY REF: 2021-1957D

RENEWS: 6-30-23