

CERTIFIED RECORD OF LAND CORNER MONUMENTATION


Refer to: Plat of Wilson 1985 Cadastral Survey
Section 14, T.4S., R.28E., W.M.

J-17

History of original corner establishment:

Frank W. Campbell, under G.L.O. contract number 507, dated June 28, 1884, set a post 4 ft. long by 4" square 24" in the ground. Post marked T45 S11 on NE face, R28E S14 on SE face, S15 on SW face and S10 on NW face; 4 notches on S edge and 2 notches on E edge. From the corner:

- A Fir, 8" dia., N68°E, 10 lks.
- A Fir, 7" dia., S53°E, 8 lks.
- A Fir, 7" dia., S10°W, 21 lks.
- A Fir, 10" dia., N68°W, 9 lks.

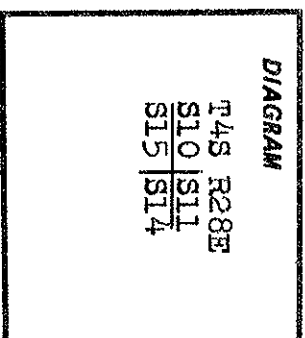

Description of corner evidence found:

- A Douglas Fir, 15" dia., S47 $\frac{1}{2}$ °E, 5.3 ft. with a healed blaze.
- A Douglas Fir, 11" dia., N63°E, 6.6 ft. with scribing visible on open blaze. This tree is dying.

I found no evidence of other BTs or corner post.

Description of monument and accessories | established to perpetuate the original location of this corner:

At the corner point established at record distance from the two original BTs I set a 2 $\frac{1}{2}$ " X 30" alum. pipe with a 3" alum. cap containing a magnet and marked:

T45 R28E
S10 S11
S15 S14
PLS 1832
1986

I built a stone mound around the monument.


From the corner new BTs:

- A Douglas Fir, 14" dia., N66°E, 47.6 ft.; marked: T45 R28E S11 BT
- A White Fir, 17" dia., S55°W, 33.6 ft.; marked: T45 R28E S15 BT
- A Douglas Fir, 16" dia., N35 $\frac{1}{2}$ °W, 53.7 ft.; marked: T45 R28E S10 BT

BTs have blaze and a 6" stripe painted red, a BT tag and an "Attention" sign. New BTs have, additionally, an alum. "PLS 1832" washer nailed to the bottom of the blaze. There is a 6' steel fence post with an "Attention" sign within 5' of the corner.

Measured to center of BTs using steel tape and staff compass. Magnetic declination set at 18°E.

June 17, 1986

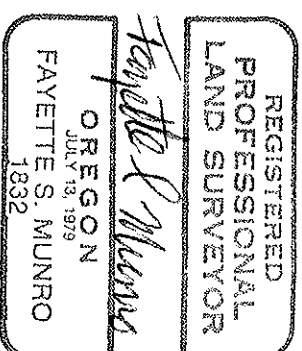

Office of Surveyor County of MORROW
 State of Oregon I hereby certify that the within instrument was filed in this office
 for record on the 21 day of July, 1986
David H. Krumbein by Michelle Daska
 (COUNTY OFFICIAL) (DEPUTY)

RECEIVED BY

Form R6-7100-57 (9/71)

Morrow County Surveyor

Date 7/21/86

Rec'd By MLD

No. 819-K