

History of original corner establishment:

Frank W. Campbell, under G.L.O. contract number 507, dated June 28, 1884, set a post 3 1/2 ft. long by 3" square 24" in the ground. Post marked 1/4 S on north face. From the corner;

A Fir, 16" dia., N38°W, 20 lks.
 A Fir, 14" dia., S16°E, 34 lks.

Description of corner evidence found:

A Douglas Fir, 20" dia., S16°E, 22.4 ft.
 marked: 1/4 S BT on opened blaze.

I found no evidence of the second BT or the corner post. These were probably destroyed by construction of a skid trail.

Description of monument and accessories | established to perpetuate the original location of this corner:

At the original corner point established at record bearing and distance from the original BT I set a 2 1/2" X 30" alum. pipe with a 3" alum. cap containing a magnet and marked:

T4S R28E
 1/4 S11
 PLS 1832
 1986

I built a stone mound around the monument.


From the corner:

A White Fir, 12" dia., S54 1/2°E, 47.7 ft.; marked: 1/4 S14 BT
 A White Fir, 9" dia., N39°E, 37.0 ft.; marked: 1/4 S11 BT

BTs have blaze and a 6" stripe painted red, a BT tag and an "Attention" sign. New BTs have, additionally, an alum. "PLS 1832" washer nailed to the bottom of the blaze. There is a 6' steel fence post with an "Attention" sign within 5' of the corner.

Measured to center of BTs using steel tape and staff compass. Magnetic declination set at 180E.

June 16, 1986

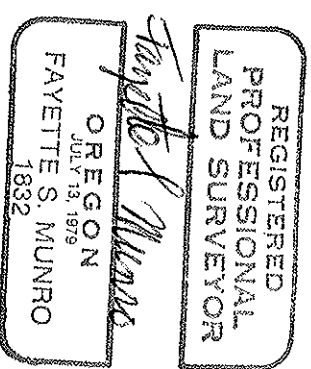

Office of Subvergal County of MORRIS
 State of Oregon. I hereby certify that the within instrument was filed in this office
 for record on the 21 day of July 1986
David H. Klumbain by Michelle Doka
 (COUNTY OFFICIAL) (DEPUTY)

RECORDED BY
 MORROW COUNTY SURVEYOR
 Date 7/21/86
 Rec'd By MJD
 No. 822-K