

CERTIFIED RECORD OF LAND CORNER MONUMENTATION

J-21


History of original corner establishment:

Corner established by Edward W. Sanderson under GLO contract No. 417 In August of 1881.

Set a Basalt stone 10 x 8 x 7 inches, 7 inches in the ground, mkd with 4 notches on S and 1 notch on E edges.

A Fir 8" dia. bears N 35°E 56 lks dist. mkd T 4S, R 28E S 12 BT
 A Pine 15" dia. bears S 35°E 48 lks dist. mkd T 4S, R 28E, S 10 BT.

A Tamarack 14" dia. bears S 55°W 18 lks dist. mkd T 4S, R 28E, S 14 BT.
 A Fir 14" dia. bears N 54°W 38 lks dist. mkd T 4S, R 28E, S 11 BT.

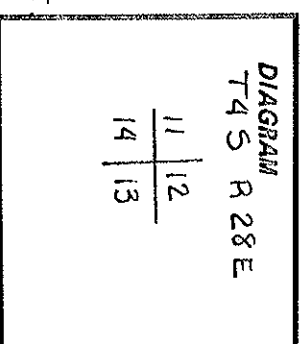

Description of corner evidence found:


Found eroded stone lying on ground. 8x6x5 inches in size, no marks visible.

A Fir 8" dia. bears N 35°E 56 lks, lying on ground with scribing.
 A Pine 22" dia. bears S 35°E 48 lks, with scribing exposed.
 A Tamarack 24" dia. bears S 55°W 18 lks, with scribing exposed, tree is dead.
 Distance from BT's to stone did not match, used distances and bearings from BT's to set corner.

Description of monument and accessories | established to perpetuate the original location of this corner:

Set a 2½" dia. Brass Cap on a 2½" x 30" Galvanized Pipe set 24" in ground from ties to BT's, marked as shown:

- A White Fir 8" dia. bears N 61°30'W a dist. of 15.6 ft. mkd T 4S, R 28E, S 11 BT.
- A White Fir 8" dia. bears N 30°E a dist. of 20.0 ft. mkd T 4S, R 28E, S 12 BT.
- A Douglas Fir 8" dia. bears S 24°E a dist. of 12.4 ft. mkd T 4S, R 28E, S 13 BT.
- A White Fir 10" dia. bears S 50°30'W a dist. of 16.1 ft. mkd T 4S, R 28E, S 14 BT.

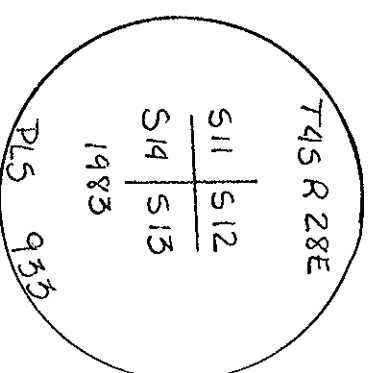

Biazes are painted red, trees have a red band painted around them, and have signs number 54-3, 54-4 and Brass Washers stamped PLS 933 nailed to them.

Bearings were run with a staff compass set at a declination of 20° East, distances were measured with a steel tape to the center of the trees.

October 24, 1983

By: Rod Punches
 Witness: Brent Reynolds

REGISTERED
 PROFESSIONAL
 LAND SURV.
David H. Klein
 OREGON
 JULY 17, 1981
 DAVID H. KLEIN
 933

SURVEYOR
 Office of..... Oregon
 State of..... Oregon
 for record on the..... day of....., 19.....
 by
 (COUNTY OFFICIAL) (DEPUTY)

RECORDED BY
 DEPUTY COUNTY SURVEYOR
 Date 10-27-83
 made by MLD
 N A-638-K