


CERTIFIED RECORD OF LAND CORNER MONUMENTATION

INDEX No. J-9

History of original corner establishment:

Corner originally established in 1873, by Zenas F. Moody, under General Land Office Contract No. 184. Surveyor Generals Notes State: Set Post in Earth mound for cor. to Secs 16-17-8-9, from which  
 A Pine 20 in dia. bears N60°E 15 lks  
 A Tamarack 24 " " " S80°W 50 lks

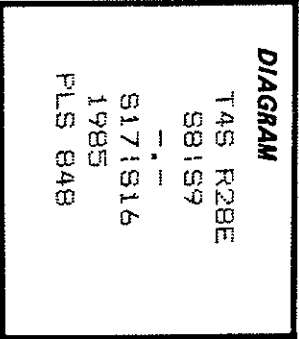

Description of corner evidence found:

No evidence of original post is found.


No evidence of original Pine Bearing tree is found at record (N60°E, 9.9 ft.)

Found dead & down Tamarack with scribing, reads "S17"  
 Set corner position at Record N80°E, 33.0 ft. from tree.

Description of monument and accessories | established to perpetuate the original location of this corner:

Set 2-1/2"x30" aluminum pipe with 2-1/2" aluminum cap, stamped as shown on the **DIAGRAM**, SET 26" in the ground.

From which,  
 A Tamarack 8" dia.; Bears, N36°W., 91.5 ft.; scribed: T4S R28E S8 BT  
 A Fir 10" dia.; Bears, N41°E.; 21.7 ft.; scribed: T4S R28E S9 BT  
 A Fir 6" dia.; Bears, S40°E.; 15.8 ft.; scribed: T4S R28E S16 BT  
 A Fir 8" dia.; Bears, S80°W.; 21.6 ft.; scribed: T4S R28E S17 BT  
 Measurements to trees taken with a metal tape and magnetic compass, with Declination set off 20 deg. East.  
 Nailed a brass washer stamped PLS 848 on blaze above BT scribe, Bearing Tree Sign above blaze, and warning sign on back of each tree. Painted a 6" red band at breast ht. around each tree. Set steel fence posts with warning signs, North S ft. from corner.

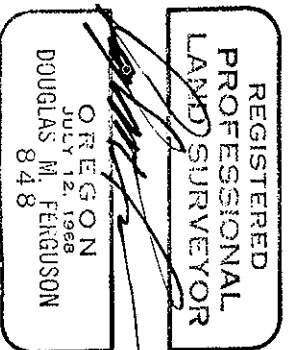

Work by D.M. Ferguson, PLS 848, Mt. Vernon Ore.  
 On June 11, 1985  
 Witnessed by J. David Brinton, PLS 2065

 State of Oregon ..... I hereby certify that the within instrument was filed in this office  
 for record on the 11th day of September ..... 1985  
David A. Kumbien ..... by Grant Reynolds  
 (COUNTY OFFICIAL) (DEPUTY)

RECEIVED BY

Form R6-7100-57 (9/71)

Morrow County Surveyor

Date 1-10-86

Rec'd By MJD

No. 769-K