


RECORD OF LAND CORNER MONUMENTATION

NORTH 1/16 CORNER SECTIONS 14 AND 15, T. 4 S., R. 28 E., W.M.

ORIGINALLY ESTABLISHED BY: Fayette S. Munro, PLS 1832

COUNTY SURVEYOR DOCUMENTATION: Map of Survey recorded 7/21/86 as C-818-K-529 and associated monumentation record filed 7/21/86

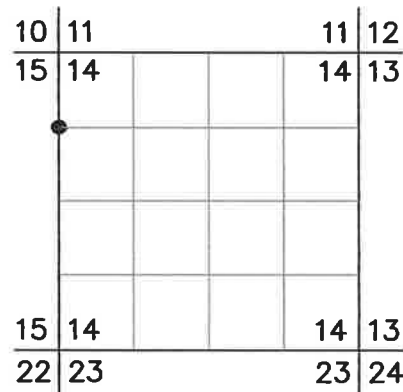

ORIGINAL DESCRIPTION: At the corner point I set a 2½"x30" alum. pipe with a 3" alum. cap containing a magnet and marked: (diagram)
I built a stone mound around the monument.

From the corner:

- A Ponderosa Pine, 20" dia., N59½°E, 67.6 ft.; marked: N1/16 S14 BT
- A Ponderosa Pine, 24" dia., N62°W, 51.2 ft.; marked: N1/16 S15 BT
- A steel fence post; N1/16 established in 1978 by B.L.M. compass survey bears S38½°W, 7.3 ft.

EVIDENCE FOUND: Found a 2½" aluminum pipe with 3¼" aluminum cap projecting 5" above ground in a 2 ft. diameter mound of stone.
From which:

- ▶ A ponderosa pine, 23" dbh bears N.59½°E., 67.6 ft. with a single healed blaze
- ▶ A ponderosa pine stump, 22" dbh and 6 ft. tall bears N.62°W., 51.2 ft. with partially healed blaze


DESCRIPTION OF MONUMENTS AND ACCESSORIES SET AND METHODS USED:

I accept the found aluminum monument for the true corner position.

MONUMENT MARKED:

From which, I SCRIBE THE FOLLOWING NEW BEARING TREES:

- ▶ A Douglas-fir, 11" dbh bears S.53°W., 13.45 ft. marked "N1/16 S15" in upper blaze and "BT" in lower blaze

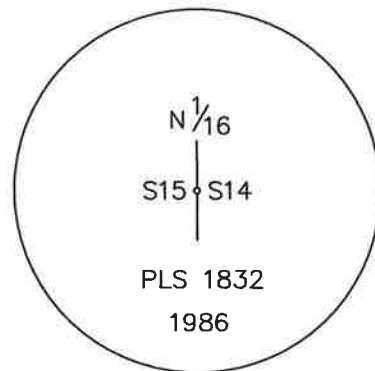

Painted a 6 inch red band around the bearing trees, and also painted the blazes red. Attached USFS signs 54-3 and 54-9 to the bearing trees. Distance to new BT measured with a steel tape, to a 60d nail set in the right-side-center at the root crown of the tree. Bearings were measured with a magnetic compass with 14° East declination.

RESTORATION BY, STAMP AND DATE:

Work Performed September 30, 2021 by:

Jason L. Hatfield, PLS
Vincent Kelly, Survey Technician
Daniel Lee



EXPIRES: 6/30/2023

USDA FOREST SERVICE
NORTHEAST OREGON LAND ZONE
1550 Dewey Avenue, Suite A
Baker City, OR 97814
(541) 523-1337

RECEIVED BY
Morrow County Surveyor
Date: 1-5-2022
Rec'd By: MPK
No.: 4528K17
Folder No.: _____