

CERTIFIED RECORD OF LAND CORNER MONUMENTATION

Refer to: Plat of Wilson 1985 Cadastral Survey  
Section 14, T.4S., R.28E., W.M.

K-17

History of original corner establishment:  
No record of previous monumentation.

DIAGRAM  
T4S R28E  
N 1/16  
S151S14

Description of corner evidence found:  
None.

Description of monument and accessories I established to perpetuate the original location of this corner:

At the corner point I set a 2 1/2" X 30" alum. pipe with a 3" alum. cap containing a magnet and marked:

N 1/16  
S15|S14  
PLS 1832  
1986

I built a stone mound around the monument.


From the corner:

A Ponderosa Pine, 20" dia., N59 1/2°E, 67.6 ft.; marked: N 1/16 S14 BT  
A Ponderosa Pine, 24" dia., N62°W, 51.2 ft.; marked: N 1/16 S15 BT  
A steel fence post; N 1/16 established in 1978 by B.L.M. compass survey bears S38 1/2°W, 7.3 ft..

BTs have blaze and a 6" stripe painted red, BT tags, "Land Survey Monument" signs and an alum. "PLS 1832" washer nailed to the bottom of the blaze. There is a 6' steel fence post with a "Land Survey Monument" sign within 5' of the corner.

Measured to center of BTs using steel tape and staff compass. Magnetic declination set at 19 1/2°E.

June 17, 1986

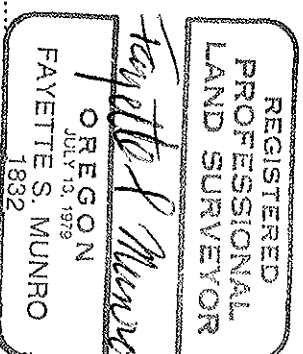

Office of Surveyor County of Morrow  
State of Oregon, I hereby certify that the within instrument was filed in this office  
for record on the 31 day of July, 1986  
David H. Kumbain by Michelle Dorka  
(COUNTY OFFICIAL) (DEPUTY)

Form R6-7100-57 (9/71)

RECEIVED BY  
Morrow County Surveyor  
Date 7/21/86  
Rec'd By MUD  
No. 823-K