

RECORD OF LAND CORNER MONUMENTATION

WEST 1/4 CORNER SECTION 14, T. 4 S., R. 28 E., W.M.


ORIGINALLY ESTABLISHED BY: Frank W. Campbell, U.S. Deputy Surveyor

CONTRACT NUMBER: 507

CONTRACT DATE: June 28, 1884

SUBSEQUENT SURVEYS:

- ▶ Remonumentation performed by Fayette S. Munro, PLS 1832, see Map of Survey recorded 7/21/86 as C-818-K-529 and associated monumentation record filed 7/21/86

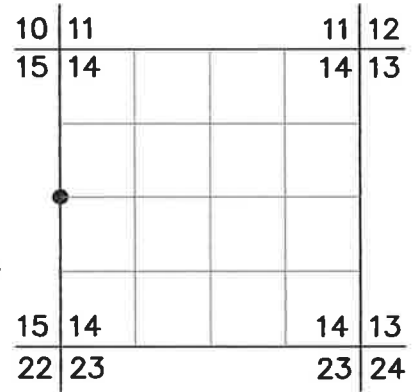

ORIGINAL DESCRIPTION: Set a basalt stone 12x10x7 ins. 8 ins. in the ground, for 1/4 sec. cor. marked 1/4 on W. face from which

- A fir 6 ins in diam. bears N50°E, 12 lks dist, marked 1/4S B.T.
- A fir 6 ins in diam. bears N35°W, 8 lks dist. marked 1/4S B.T.

MUNRO'S 1986 DESCRIPTION: Description of evidence found: None. At proportionate distance I set a 2½"x30" alum. pipe with a 3" alum. cap containing a magnet and marked: (diagram shown)
I built a stone mound around the monument.

From the corner:

- A Tamarack, 10" dia., N28°E, 6.4 ft.; marked: 1/4 S14 BT
- A Tamarack, 10" dia., S73½°W, 22.3 ft.; marked: 1/4 S15 BT

EVIDENCE FOUND: Found a 2½" aluminum pipe with 3¼" aluminum cap projecting 4" above ground in a 2 ft. diameter mound of stone.

From which:

- ▶ A western larch, 15" dbh bears N.28°E., 6.4 ft. with a healed single blaze, alive and healthy
- ▶ A western larch 11" dbh bears S.73½°W., 22.3 ft. with healed single blaze, alive and healthy

DESCRIPTION OF MONUMENTS AND ACCESSORIES SET AND METHODS USED:


I accept the found aluminum monument for the true corner position.

MONUMENT MARKED:

From which, I SCRIBE THE FOLLOWING NEW BEARING TREES:

- ▶ A western larch, 10" dbh bears N.25°W., 6.48 ft. marked "1/4 S15" in upper blaze and "BT" in lower blaze
- ▶ A white fir, 7" dbh bears S.24°E., 25.5 ft. marked "X" in upper blaze and "BT" in lower blaze

Painted a 6 inch red band around the bearing trees, and also painted the blazes red. Attached USFS signs 54-3 and 54-9 to the bearing trees. Distance to new BT's measured with a steel tape, to a 60d nail set in the right-side-center at the root crown of each tree. Bearings were measured with a magnetic compass with 14° East declination.

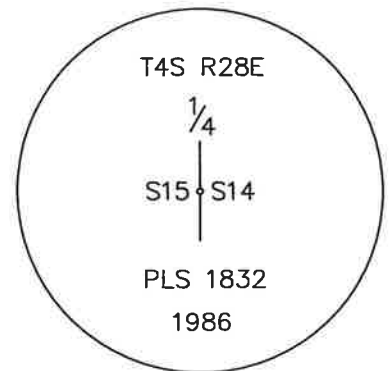

RESTORATION BY, STAMP AND DATE:

Work Performed September 30, 2021 by:

Jason L. Hatfield, PLS
Vincent Kelly, Survey Technician
Daniel Lee



EXPIRES: 6/30/2023

USDA FOREST SERVICE
NORTHEAST OREGON LAND ZONE
1550 Dewey Avenue, Suite A
Baker City, OR 97814
(541) 523-1337

RECEIVED BY
Morrow County Surveyor

Date: 1-5-2022

Rec'd By: MPK

No.: 4528L17

Folder No.: _____