

CERTIFIED RECORD OF LAND CORNER MONUMENTATION

Refer to: Plat of Wilson 1985 Cadastrol Survey
Section 14, T4S., R.28E., W.M.

L-17

DIAGRAM

T4S R28E
1/4
S15|S14

History of original corner establishment:

Frank W. Campbell, under G.L.O. contract number 507, dated June 28, 1884, set a basalt stone 12"X 10"X 7" eight inches in the ground. Stone marked 1/4 on west face.

From the corner:

A Fir, 6" dia., N500E, 12 lks.
A Fir, 6" dia., N300W, 8 lks.

Description of corner evidence found:

None.

Description of monument and accessories | established to perpetuate the original location of this corner:

At proportionate distance I set a 2 1/2"X 30" alum. pipe with a 3" alum. cap containing a magnet and marked:

T4S R28E
1/4
S15|S14
PLS 1832
1986

I built a stone mound around the monument.


From the corner:

A Tamarack, 10" dia., N280E, 6.4 ft.; marked: 1/4 S14 BT
A Tamarack, 10" dia., S73 1/2 W, 22.3 ft.; marked: 1/4 S15 BT

BTs have blaze and a 6" stripe painted red, a BT tag, an "Attention" sign and an alum. "PLS 1832" washer nailed to the bottom of the blaze. There is a 6' steel fence post with an "Attention" sign within 5' of the corner.

Measured to center of BTs using steel tape and staff compass. Magnetic declination set at 180E.

June 17, 1986

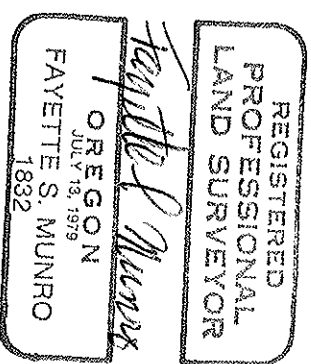

Office of David H. Kumbain County of Marion
State of Oregon I hereby certify that the within instrument was filed in this office
for record on the 21 day of July, 1986
David H. Kumbain by Michelle Dorka
(COUNTY OFFICIAL) (DEPUTY)

Form R6-7100-57 (9/71)

RECORDED BY
Marion County Surveyor
Date 7/21/86
Rec'd By MLD
No. 821-K