

CERTIFIED RECORD OF LAND CORNER MONUMENTATION

INDEX NO., N-11

**History of original corner establishment:**

Corner originally established in 1873, by Zenas F. Moody, under General Land Office Contract No. 184. Surveyor General's Notes State: Set a Stone 16x10x7 for 1/4 S cor.

<b>DIAGRAM</b>	
T4S R28E	
S16	
1/4-.-	
S21	
1984	
PLS 848	

**Description of corner evidence found:**

No evidence found, the corner has been lost to road construction activities.

No accessories originally established.

Established corner position by proportionate measure between section corners found 1/2 mi. East & West.

**Description of monument and accessories I established to perpetuate the original location of this corner:**

Set 2-1/2"x30" aluminum pipe with 2-1/2" aluminum cap, stamped as shown on the **DIAGRAM**, SET 28" in the ground.


From which,

A Spruce 12" dia. Bears, N50°E., 5.4 ft., scribed: 1/4 S16 BT

A Tamarack 12" dia. Bears, S32°W., 32.5 ft., scribed: 1/4 S21 BT

Measurements to trees taken with a metal tape and magnetic compass, with Declination set off 20 deg. East.

Nailed a brass washer stamped PLS 848 on blaze above BT scribe, Bearing Tree Sign above blaze, and warning sign on back of each tree. Painted a 6" red band at breast ht. around each tree. Set steel fence post with warning sign, North 1 ft. from the corner.

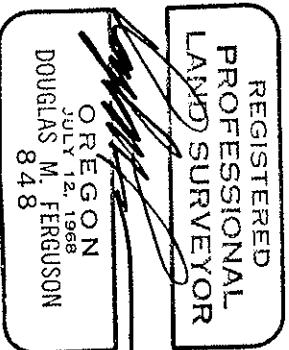

Work by D.M. Ferguson, PLS 848, Mt. Vernon Ore.  
On Aug. 15, 1984  
Witnessed by J. David Brinton, PLS 2065

Office of..... *Silverdale* ..... County of..... *MORROW* .....  
State of *Oregon* ..... I hereby certify that the within instrument was filed in this office  
for record on the *10th* day of..... *September*..... 19*85*  
..... *David H. Krumbein* ..... by..... *David M. Ferguson* .....  
(COUNTY OFFICIAL) (DEPUTY)

Form R6-7100-57 (9/71)

RECEIVED BY

Morrow County Surveyor

*144-1-1D-86*

*David MLD*

*761-K*