

CERTIFIED RECORD OF LAND CORNER MONUMENTATION

INDEX No. N-13
History of original corner establishment:

Corner originally established in 1873, by Zenas F. Moody, under General Land Office Contract No. 184. Surveyor Generals Notes State: Set stone 24x18x10, in stone mound for cor. to Secs. 21-22-15-16.

DIAGRAM	
T4S R28E	
S161815	
--	
S211522	
1984	
PLS 848	

Description of corner evidence found:

Found 24"x18"x12" stone, under logging slash, supported, on downhill (west) side by a mound 3 grooves clearly visible on the east face of above described stone.


No accessories originally established. Accepted the above described stone as the sec. cor. position.

Description of monument and accessories I established to perpetuate the original location of this corner:

Set 2-1/2"x30" aluminum pipe with 2-1/2" aluminum cap, stamped as shown on the **DIAGRAM**, SET 10" in the ground, & original stone NW alongside pipe and raised a mound of stone around the pipe.

From Which:

A Fir 10" dia. Bears, N72°W., 58.7 ft., scribed: T4S R28E S16 BT
 A Fir 14" dia. Bears, N31°E., 82.6 ft., scribed: T4S R28E S15 BT
 Set a 5/8"x30" iron pin with plastic cap stamped PLS 848 SURVEY MARKER, Bears, S28°E., 2.6 ft., set a steel post with Bearing Tree and Warning signs alongside pin.
 A Tamarack 14" dia. Bears, S33°W., 99.0 ft., scribed: T4S R28E S21 BT
 Measurements to trees taken with a metal tape and magnetic compass, with Declination set off 20 deg. East.
 Nailed a brass washer stamped PLS 848 on blaze above BT scribe, Bearing Tree Sign above blaze, and warning sign on back of each tree. Painted a 6" red band at breast ht. around each tree.

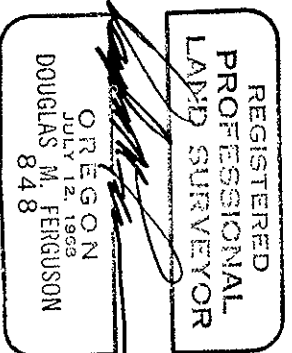

Work by D.M. Ferguson, PLS 848, Mt. Vernon Ore.
 On July 25, 1984
 Witnessed by J. David Brinton, PLS 2065

 State of *Oregon*..... I hereby certify that the within instrument was filed in this office
 for record on the *15th* day of *September*, 198*4*
David A. Kumbier..... by *S. Brainerd* *Deputy*
 (COUNTY OFFICIAL) (DEPUTY)

Form R6-7100-57 (9/71)

RECORDED BY


Date *1-15-86*

Rec'd *JDLD*

No. *198-K*