


CERTIFIED RECORD OF LAND CORNER MONUMENTATION

INDEX No. N-17

History of original corner establishment:

Corner originally established in 1884, by Frank W. Campbell, under General Land Office contract No. 507.1; Surveyor General's Notes State: Set a post, 4 ft. long, 4 ins square, 24 ins. in the ground, for cor. to Secs. 14, 15, 22 & 23 marked, T4S S14 on NE, R28E S23 on SE, S22 on SW, and S15 on NW faces, with 3 notches on S and 2 notches on E edges. from which:
 A fir 24 ins. in diam. bears N75°E., 9 lks. dist. marked T4S R28E S14 BT
 A tamarack 20 ins. in diam. bears S65°E., 28 lks dist. marked T4S R28E S23 BT
 A fir 28 ins. in diam. bears S25°W., 86 lks. dist. marked T4S R28E S22 BT
 A fir 28 ins. in diam. bears N43°W., 6 lks. dist. marked T4S R28E S15 BT

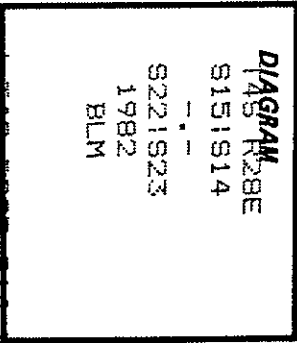

In 1982 the Bureau of Land Management re-monumented this corner, from existing original evidence.

Description of corner evidence found:

Found a 3-1/2" aluminum cap monument, stamped as shown on the **DIAGRAM**


Found a Fir, 30" dia., an original bearing tree, in the NE (S14) Quadrant, dead.

Found three new bearing trees as taken by the BLM, in 1982, live, in good condition.

Description of monument and accessories | established to perpetuate the original location of this corner:

Maintained corner by setting a steel post with warning sign, South alongside monument.

Maintained Accessories as follows:
 Scribed a New Bearing Tree, A Spruce, 12" dia. Bears, N53E., 30.0 ft. scribed, T4S R28E S14 BT.
 Measurements to trees taken with a metal tape and magnetic compass, with Declination set off 20 deg. East.
 Nailed Bearing tree sign above blaze, and warning sign on back of each tree & painted a 6" red band at breast ht. around each tree. Nailed a brass washer stamped PLS 848, above BT scribe on the new bearing tree.

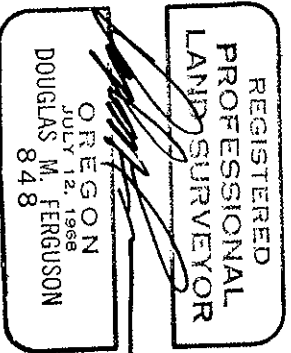

Work by D.M. Ferguson, PLS 848, Mt. Vernon Ore.
 On July 25, 1984
 Witnessed by J. David Brinton, PLS 2065

Office of..... Surveyor..... County of Marion.....
 State of Oregon..... I hereby certify that the within instrument was filed in this office
 for record on the 12th day of September, 1985
 by David H. Krumbein by David H. Krumbein (DEPUTY)
 (COUNTY OFFICIAL)

RECEIVED BY

Form R6-7100-57 (9/71)

Morrow County Surveyor

Date 1-10-86
 Rec'd by BLM
 No. 772-1c