

**CERTIFIED RECORD OF LAND CORNER MONUMENTATION**

INDEX No. N-9

**History of original corner establishment:**

Corner originally established in 1873, by Zenas F. Moody, under General Land Office Contract No. 184, Surveyor Generals Notes State; Set a post in stone mound for cor. to Secs. 21-21-16-17.

<b>DIAGRAM</b>	
T4S R28E	
S171S16	
-----	
S201S21	
1984	
PLS 848	

**Description of corner evidence found:**


No evidence is found, corner falls on a steep SE slope in logging slash and a road fill just above the corner. Corner has been lost to this acidity.

No accessories originally established, however there is a call to a spring branch 198 ft. south from corner position. Therefore the spring branch is tied, and the corner positioned by proportionate measurement from corners found 1 mi. East & West, for E-W position, with N-S position determined at 198 ft. North from the spring branch. (Proportioned North-South position would fall 68 ft. South from the above described location, in order to meet this condition the position would need to move west more than 100 ft., whereby the location would not fit with the surrounding pattern of evidence. Therefore the spring branch as called determines the North South position of the corner.)

**Description of monument and accessories | established to perpetuate the original location of this corner:**

Set 2-1/2"x30" aluminum pipe with 2-1/2" aluminum cap, stamped as shown on the **DIAGRAM**, SET 12" in the ground, & raised a mound of stone and earth around the pipe.

- From Which:
- A Fir 16" dia. Bears, N 6<sup>0</sup>W., 29.6 ft., scribed: T4S R28E S17 BT
  - A Pine 14" dia. Bears, N80<sup>0</sup>E., 30.4 ft., scribed: T4S R28E S16 BT
  - A Fir 12" dia. Bears, S 3<sup>0</sup>E., 18.5 ft., scribed: T4S R28E S21 BT
  - A Fir 8" dia. Bears, S23<sup>0</sup>W., 24.0 ft., scribed: T4S R28E S20 BT
- Measurements to trees taken with a metal tape and magnetic compass, with Declination set off 20 deg. East.
- Nailed a brass washer stamped PLS 848 on blaze above BT scribe, Bearing Tree Sign above blaze, and warning sign on back of each tree. Painted a 6" red band at breast ht. around each tree. Set steel fence post with warning sign, North 1 ft. from the corner.

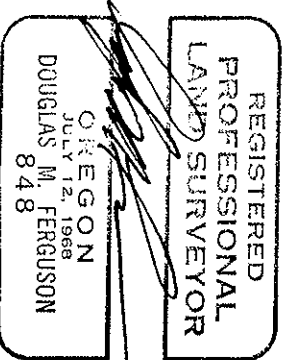

Work by D.M. Ferguson, PLS 848, Mt. Vernon Ore.  
 On Aug. 15, 1984  
 Witnessed by J. David Brinton, PLS 2065

Office of..... Surveyor..... County of..... MARION.....  
 State of..... OREGON..... I hereby certify that the within instrument was filed in this office  
 for record on the 15th day of..... September..... 1985  
David H. Krumbain..... by..... David M. Ferguson  
 (COUNTY OFFICIAL) (DEPUTY)