


CERTIFIED RECORD OF LAND CORNER MONUMENTATION

INDEX No., P-11

History of original corner establishment:

Corner not previously established.

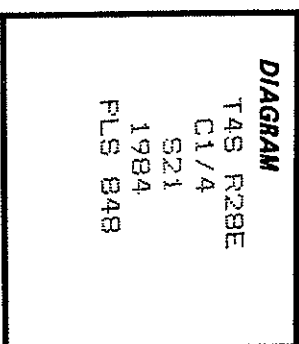

Description of corner evidence found:

Corner not previously established.

Description of monument and accessories I established to perpetuate the original location of this corner:


Set 2-1/2"x30" aluminum pipe with 2-1/2" aluminum cap, stamped as shown on the **DIAGRAM**, SET 25" in the ground, on west cut-slope of primitive rd. from which.

A Fir 14" dia. Bears, S52°E., 49.5 ft., scribed C1/4 S21 BT

A Fir 10" dia. Bears, S30°W., 11.2 ft., scribed C1/4 S21 BT

Measurements to trees taken with a metal tape and magnetic compass, with Declination set off 20 deg. East.

Nailed a brass washer stamped PLS 848 on blaze above BT scribe, Bearing Tree Sign above blaze, and warning sign on back of each tree. Painted a 6" red band at breast ht. around each tree. Set steel fence post with warning sign, North 2 ft. from the corner.

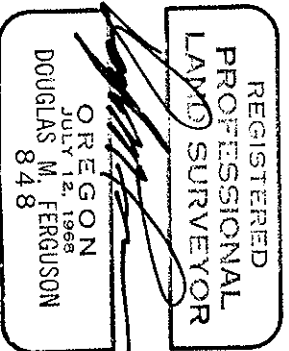

Work by D.M. Ferguson, PLS 848, Mt. Vernon Ore  
 On Aug. 16, 1984  
 Witnessed by J. David Brinton, PLS 2065

Office of..... S. Kuehner..... Copy of M. K. Kell  
 State of Oregon..... I hereby certify that the within instrument was filed in this office  
 for record on the 10th day of September, 1985  
David H. Kuehner by Samuel Raymoley  
 (COUNTY OFFICIAL) (DEPUTY)

RECEIVED BY  
 Morrow County Surrogor  
 Date 1-10-86  
 Rec'd By M.L.D.  
 No. 267-K