


CERTIFIED RECORD OF LAND CORNER MONUMENTATION

P-12

History of original corner establishment:

Corner not previously established.

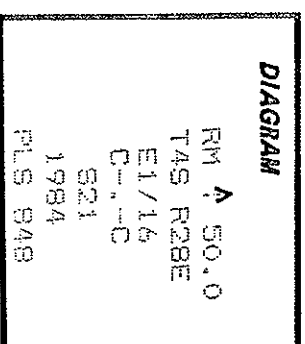

Description of corner evidence found:

Corner not previously established.

Description of monument and accessories | established to perpetuate the original location of this corner:

Corner is on a near vertical decomposed Granite face, Set a 5/8"x30" iron pin with a plastic cap stamped PLS 848 SURVEY MARKER

From which:

Set 2-1/2"x30" aluminum pipe with 2-1/2" aluminum cap, Bears 50°06' 23"W., stamped as shown on the DIAGRAM, SET 20" in the ground, Bears 50°06' 23"W., 50.00 ft.,


A 5/8"x30" iron pin with plastic cap, stamped PLS 848 SURVEY MARKER, Bears, NB4° 22' 36"W., 59.8 ft., & set a steel fence post with Bearing Tree and warning signs attached, set alongside the pin.

Center Line Station, 967+85, of the Re-located Willow Cr. Road, Bears, 570° 00' 20"W., 102.8 ft.

A pine 7" dia. Bears, 810°W., 50.0 ft., scribed: C-E 1/16 S21 BT.

Measurements to Accessories taken with total station electronic equipment with directions based on project control survey.

Nailed a brass washer stamped PLS 848 on blaze above BT scribe, Bearing Tree sign above blaze, and warning sign on back tree. Painted a 6" red band at breast ht. around tree.

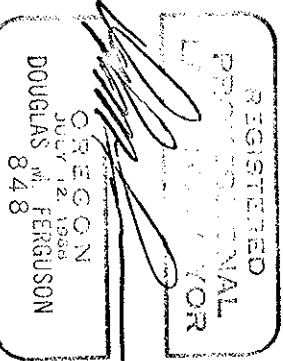

Work by D.M. Ferguson, PLS 848, Mt. Vernon Ore.
 On July 27, 1984
 Witnessed by J. David Brinton, PLS 2065

Office of..... Sherlock County of..... Marion

State of..... Oregon I hereby certify that the within instrument was filed in this office
 for record on the 11th day of..... September....., 1985
David H. Krumboltz..... by..... David H. Krumboltz.....
 (COUNTY OFFICIAL) (DEPUTY)

Form R6-7100-57 (9/71) *ORO-798-276

Notary County (over you) Marion
 Date 1-10-86
 Rec'd by DMLD
PLS 799-K