

CERTIFIED RECORD OF LAND CORNER MONUMENTATION

INDEX No. P-13

History of original corner establishment:

Corner originally established in 1873, by Zenas F. Moody, under General Land Office Contract No. 184. Surveyor General's Notes, State: Set stone 18x10x7 in stone mound, for 1/4 Sec. Cor.

DIAGRAM	
T4S R28E	
1/4	
521, 522	
1	
1984	
PLS 848	


Description of corner evidence found:

Corner is on a steep west slope, the original stone mound has apparently eroded out and rolled down the slope.

No Accessories originally established.
 Established position of corner at proportionate measure between corners found 1/2 mi. North & South.
 Corner falls approx. 150 ft. south from a timber cut line, in heavy timber.

Description of monument and accessories | established to perpetuate the original location of this corner:

Set 2-1/2"x30" aluminum pipe with 2-1/2" aluminum cap, stamped as shown on the **DIAGRAM**, SET 18" in the ground, and raised a mound of stone and earth around the pipe.
 From which:
 A Fir 10" dia. Bears, S16°W., 11.2 ft., scribed: 1/4 S21 BT
 A Fir 8" dia. Bears, S81°E., 18.0 ft., scribed: 1/4 S22 BT
 Measurements to trees taken with a metal tape and magnetic compass, with Declination set off 20 deg. East.
 Nailed a brass washer stamped PLS 848 on blaze above BT scribe, Bearing Tree Sign above blaze, and warning sign on back of each tree. Painted a 6" red band at breast ht, around each tree. Set steel fence posts with warning & Boundary Signs, East 8 ft. & West 5 ft. from the corner.

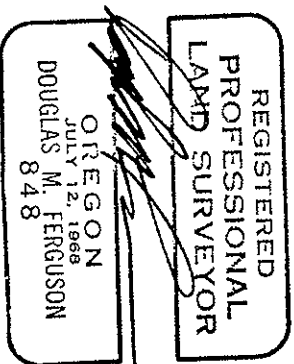

Work by D.M. Ferguson, PLS 848, Mt. Vernon Ore.
 On July 26, 1984
 Witnessed by J. David Brinton, PLS 2065

Office of..... SURVEYOR..... County of MORROW.....
 State of Oregon..... I hereby certify that the within instrument was filed in this office
 for record on the 10th day of September, 1985
David H. Keumlein..... by David H. Keumlein.....
 (COUNTY OFFICIAL) (DEPUTY)

Form R6-7100-57 (9/71)

RECEIVED BY
Morrow County Surveyor
 Date 1-10-86
 held by MLD
 No. 997-R