


CERTIFIED RECORD OF LAND CORNER MONUMENTATION

INDEX No., P-15

History of original corner establishment:

Corner not previously established.

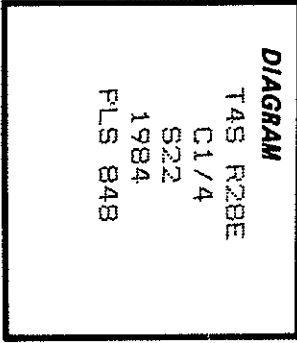

Description of corner evidence found:

Corner not previously established.

Description of monument and accessories | established to perpetuate the original location of this corner:

Set 2-1/2"x30" aluminum pipe with 2-1/2" aluminum cap, stamped as shown on the **DIAGRAM**, SET 18" in the ground, & raised a mound of stone around the pipe.


From which:

A Pine 12" dia. Bears, N73°W., 13.1 ft., scribed: C1/4 S22 BT

A Pine 6" dia. Bears, S10°E., 7.6 ft., scribed: C1/4 S22 BT

Measurements to trees taken with a metal tape and magnetic compass, with Declination set off 20 deg. East.

Nailed a brass washer stamped PLS 848 on blaze above BT scribe, Bearing Tree Sign above blaze, and warning sign on back of each tree. Painted a 6" red band at breast ht. around each tree. Set steel fence posts with warning & Boundary Signs, East & West, 5 ft. from the corner.

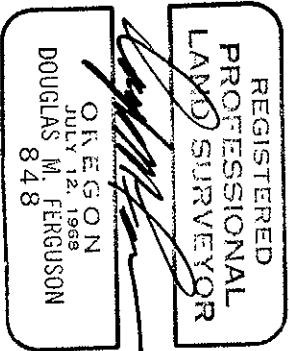

Work by D.M. Ferguson, PLS 848, Mt. Vernon Ore.
 On July 25, 1984
 Witnessed by J. David Brinton, PLS 2065

Office of..... Subveyor..... County of..... Madras.....
 State of Oregon..... I hereby certify that the within instrument was filed in this office
 for record on the 25th day of..... September..... 1985
 by..... David H. Kramlein..... by..... D. M. Ferguson.....
 (COUNTY OFFICIAL) (DEPUTY)

RECORDED BY
 Morrow County Surveyor
 Date 1-10-86
 Rec'd by MJD
 No. 196-K