

CERTIFIED RECORD OF LAND CORNER MONUMENTATION

INDEX No. P-17

History of original corner establishment:

Corner originally established in 1884, by Frank W. Campbell, under General Land Office Contract No. 507. Surveyor Generals Notes State: Set a Granite Stone 16x10x6 ins. 11 in. in the ground for 1/4 cor., marked 1/4 on W face.

From which:

A pine 4 ins. in diam. bears S82°E., 31 lks. dist. marked 1/4 S BT
A pine 40 ins. in diam. bears S65°W., 16 lks. dist. marked 1/4 S BT

DIAGRAM	
T4S R2BE	
1/4	
!	
S22, S23	
1984	
FLS 848	

Description of corner evidence found:

Found 16"x8"x8" stone with possible 1/4 marks, loose, displaced westerly 44 ft. from corner position.

Found 40" Pine stump and remains of tree alongside, with scribing visible, but not legible.

Set corner position at record N65E., 10.6 ft., from face of stump.

Description of monument and accessories | established to perpetuate the original location of this corner:

Set 2-1/2"x30" aluminum pipe with 2-1/2" aluminum cap, stamped as shown on the **DIAGRAM**, SET 18" in the ground, & raised a mound of stone around the pipe.


From which:

A Pine 16" dia. Bears, N78E., 54.2 ft., scribed: 1/4 S23 BT

A Pine 20" dia. Bears, S38W., 44.3 ft., scribed: 1/4 S22 BT

Measurements to trees taken with a metal tape and magnetic compass, with Declination set off 20 deg. East.

Nailed a brass washer stamped PLS 848 on blaze above BT scribe, Bearing Tree Sign above blaze, and warning sign on back of each tree. Painted a 6" red band at breast ht. around each tree. Set steel fence posts with warning & Boundary Signs, North & West 5 ft. from the corner.

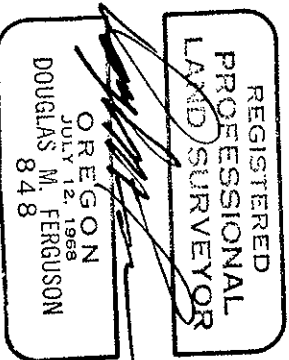

Work by D.M. Ferguson, FLS 848, Mt. Vernon Ore
On July 25, 1984
Witnessed by J. David Brinton, PLS 2065

Office of..... Sikuler County of MORRIS
State of Oregon I hereby certify that the within instrument was filed in this office
for record on the 11th day of September, 1985
David H. Kraumbien by S. Brent Reynolds
(COUNTY OFFICIAL) (DEPUTY)

RECORDED BY

Form R6-7100-57 (9/71)

MORRIS County Surveyor

ORO-798-276

Date 1-10-86

Book 5 MLD

No. 283-K