


CERTIFIED RECORD OF LAND CORNER MONUMENTATION

INDEX No. P-9

History of original corner establishment:

Corner originally established in 1873, by Zenas F. Moody, under General Land Office Contract No. 184. Surveyor General's Notes State: Set Stone 15x10x8 for 1/4 S Cor.

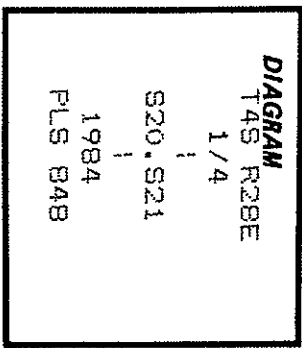

Description of corner evidence found:

No evidence found, corner has been lost to road construction and logging activity.

No accessories originally established.

Set corner position at proportionate measure, between corners previously established 1/2 mi. North & South.

Description of monument and accessories I established to perpetuate the original location of this corner:

Set 2-1/2"x30" aluminum pipe with 2-1/2" aluminum cap, stamped as shown on the **DIAGRAM**, SET 12" in the ground, & raised a mound of stone and earth around the pipe.


From which:

A Fir 10" dia. Bears, 569⁰W., 37.2 ft., scribed: 1/4 S20 BT

A Fir 10" dia. Bears, 540⁰E., 12.9 ft., scribed: 1/4 S21 BT

Measurements to trees taken with a metal tape and magnetic compass, with Declination set off 20 deg. East.

Nailed a brass washer stamped PLS 848 on blaze above BT scribe, Bearing Tree Sign above blaze, and warning sign on back of each tree. Painted a 6" red band at breast ht. around each tree. Set steel fence post with warning sign, North 5 ft. from the corner.

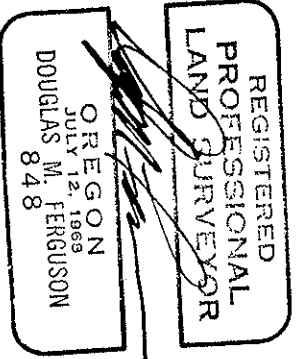

Work by D.M. Ferguson, PLS 848, Mt. Vernon Ore.
On Aug. 15, 1984
Witnessed by J. David Brinton, PLS 2065

State of OREGON I hereby certify that the within instrument was filed in this office
for record on the 10th day of September, 1985
by David H. Kumbain (COUNTY OFFICIAL) by S. N. Nix (DEPUTY)