


# RECORD OF LAND CORNER MONUMENTATION

SOUTHEAST 1/16 CORNER SECTION 21, T. 4 S., R. 28 E., W.M.

ORIGINALLY ESTABLISHED BY: Douglas M. Ferguson, PLS 848

COUNTY SURVEYOR DOCUMENTATION: Map of Survey recorded 1/10/86 as D-802-K-652 and associated monumentation record filed 1/10/86

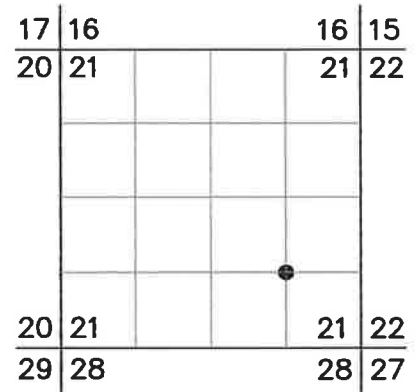

**ORIGINAL DESCRIPTION:** Set 2-1/2"x30" aluminum pipe with 2-1/2" aluminum cap, stamped as shown on the DIAGRAM, set 23" in the ground.  
From which,

- A Spruce, 12" dia. Bears, S42°W., 37.8 ft., scribed: SE 1/16 S21 BT
- A Spruce, 16" dia. Bears, N46°W., 18.2 ft., scribed: SE 1/16 S21 BT

**EVIDENCE FOUND:** Found a 2 1/2" aluminum pipe with 2 1/2" aluminum cap projecting 7" above ground. Also found the dead and down remains of both bearing trees.


**DESCRIPTION OF MONUMENTS AND ACCESSORIES SET AND METHODS USED:**

I accept the found aluminum monument for the true corner position.

MONUMENT MARKED:

From which, I SCRIBE THE FOLLOWING NEW BEARING TREES:

- ▶ A lodgepole pine, 5" dbh bears N.7°E., 16.2 ft. marked "SE1/16 S21" in upper blaze and "BT" in lower blaze
- ▶ A white fir, 8" dbh bears S.74°W., 12.40 ft. marked "SE1/16 S21" in upper blaze and "BT" in lower blaze

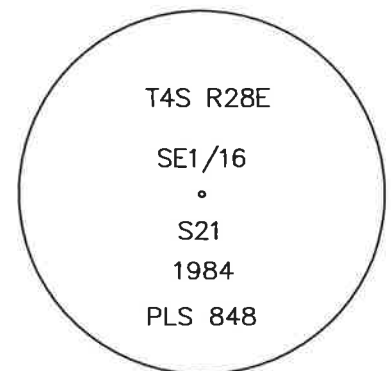

Painted a 6 inch red band around the bearing trees, and also painted the blazes red and attached USFS signs 54-3 and 54-9. Distances measured with a steel tape, to a steel spike set in the right-side-center at the root crown of each tree. Bearings were measured with a magnetic compass with 14° East declination.

**RESTORATION BY, STAMP AND DATE:**

Work Performed December 1, 2021 by:

Toribio D. Quinones, LSIT

USDA FOREST SERVICE  
NORTHEAST OREGON LAND ZONE  
1550 Dewey Avenue, Suite A  
Baker City, OR 97814  
(541) 523-1337

**RECEIVED BY**  
Morrow County Surveyor

Date: 1-5-2022  
Rec'd By: MPK  
No.: 4528Q12  
Folder No.: \_\_\_\_\_



EXPIRES: 6/30/2023