


CERTIFIED RECORD OF LAND CORNER MONUMENTATION

INDEX NO. 0-14

History of original corner establishment:

Corner not previously established.

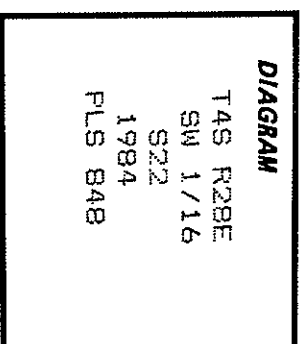

Description of corner evidence found:

Corner not previously established.

Description of monument and accessories | established to perpetuate the original location of this corner:

Set 2-1/2"x30" aluminum pipe with 2-1/2" aluminum cap, stamped as shown on the **DIAGRAM**, SET 14" in the ground, and raised a mound of stone around the pipe.


From Which:

A Pine 23" dia. Bears N53°W., 21.5 ft., scribed: SW 1/16 S22 BT

A Pine 20" dia. Bears N43°E., 29.1 ft., scribed: SW 1/16 S22 BT

Measurements to trees taken with a metal tape and magnetic compass, with Declination set off 20 deg. East.

Nailed a brass washer stamped PLS 848 on blaze above BT scribe, Bearing Tree Sign above blaze, and warning sign on back of each tree. Painted a 6" red band at breast ht. around each tree. Set steel fence posts with warning & Boundary Signs, South and West 5 ft. from the corner.

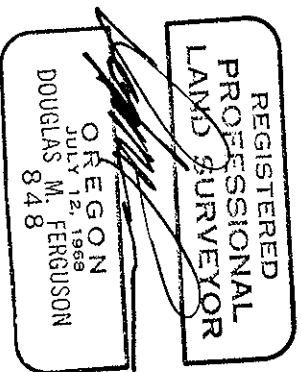

Work by D.M. Ferguson, PLS 848, Mt. Vernon Ore.
 On July 27, 1984
 Witnessed by J. David Brinton, PLS 2065

 State of Oregon I hereby certify that the within instrument was filed in this office
 for record on the 10th day of September, 1985
David H. Krumbein by David H. Krumbein Raymond J.
 (COUNTY OFFICIAL) (DEPUTY)

Form R6-7100-57 (9/71)

RECORDED BY

MORROW COUNTY SURVEYOR

Date 1-15-86

Filed by MLD

No. 289-K