

CERTIFIED RECORD OF LAND CORNER MONUMENTATION

INDEX No. R-11

History of original corner establishment:

Corner originally established in 1873, by Zenas F. Moody, under General Land Office Contract No. 184. Surveyor General's Notes State: Set post in earth mound for 1/4 Sec. Cor.

DIAGRAM	
T43	R28E
S21	
1/4-	-
S28	
1984	
PLS	848

Description of corner evidence found:

No evidence of post or mound, all traces have completely deteriorated.

No accessories originally established.


Set corner at proportionate measurement between the proportioned corner 1/2 mi. West and the corner found 1/2 mi. East.

Description of monument and accessories | established to perpetuate the original location of this corner:

Set 2-1/2"x30" aluminum pipe with 2-1/2" aluminum cap, stamped as shown on the **DIAGRAM**, SET 24" in the ground.

From Which:
A Fir 8" dia. Bears N 70°E., 60.8 ft., Scribed: 1/4 S21 BT
A Fir 6" dia. Bears S32°W., 27.0 ft.; Scribed: 1/4 S28 BT
Measurements to trees taken with a metal tape and magnetic compass, with Declination set off 20 deg. East.

Nailed a brass washer stamped PLS 848 on blaze above BT scribe, Bearing Tree Sign above blaze, and Warning sign on back of each tree. Painted a 4" red band at breast ht. around each tree. Set steel fence post with warning sign North 5 ft. from corner.

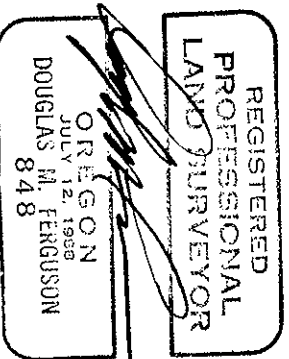

Work by D.M. Ferguson, PLS 848, Mt. Vernon Ore.
On Aug. 15, 1984
Witnessed by J. David Brinton, PLS 2065

Office of..... Surveyor..... 14
County of MORRIS
State of Oregon..... I hereby certify that the within instrument was filed in this office
for record on the 10th day of September, 1984
by David H. Kumbert by David H. Kumbert
(COUNTY OFFICIAL) (DEPUTY)

RECEIVED BY
Morrow County Surveyor
Date 1-10-86
Rec'd By MUD
No. 766-R