

CERTIFIED RECORD OF LAND CORNER MONUMENTATION

INDEX No. R-13

History of original corner establishment:

Corner originally established in 1873, by Zenas F. Moody, under General Land Office Contract No. 184. Surveyor Generals Notes State: Set post in earth mound for cor. to Secs. 27-28-21 & 22

DIAGRAM	
T4S R28E	
S211S22	
-.-	
S281S27	
1984	
PLS 848	


Description of corner evidence found:

Found the end of the original post, a pointed end and squared, in an earth mound, remains of post is approx. 12" under the surface of the ground. Found newer post with tag, (approx. 1/16) 3 ft. North.

No accessories originally established. Right of Way Map, Oregon Forest Highway Project FH 109 Willow Creek, Morrow County, Sheet 17 of 18, ties the approx. 1/16 corner as described above, 3 ft. North from the original corner. Accepted the remains of the original post as described above as the Section Corner.

Description of monument and accessories | established to perpetuate the original location of this corner:

Set 2-1/2"x30" aluminum pipe with 2-1/2" aluminum cap, stamped as shown on the **DIAGRAM**, SET 24" in the ground, placed remains of post alongside. From which.
A Fir 18" dia. Bears, NS4W., 7.3 ft., scribed: T4S R28E S21 BT
A Fir 8" dia. Bears, N 1E., 10.8 ft., scribed: T4S R28E S22 BT
A Fir 10" dia. Bears, S71E., 58.3 ft., scribed: T4S R28E S27 BT
A Fir 10" dia. Bears, S50W., 9.0 ft., scribed: T4S R28E S28 BT
Measurements to trees taken with a metal tape and magnetic compass, with Declination set off 20 deg. East.
Nailed a brass washer stamped PLS 848 on blaze above BT scribe, Bearing Tree Sign above blaze, and warning sign on back of each tree. Painted a 4" red band at breast ht. around each tree. Set steel fence post with warning Sign, North 1.3 ft. from the corner.

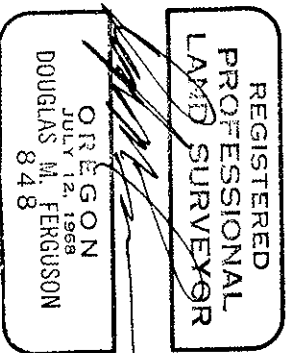

Work by D.M. Ferguson, PLS 848, Mt. Vernon Ore.
On July 30, 1984
Witnessed by J. David Brinton, PLS 2065

Office of..... Surety..... County of..... MORROW.....
State of Oregon..... I hereby certify that the within instrument was filed in this office
for record on the 10th day of..... September..... 1985
..... David H. Krimben..... by..... Sandra Ray.....
(COUNTY OFFICIAL) (DEPUTY)