

CERTIFIED RECORD OF LAND CORNER MONUMENTATION

INDEX No. R-14

History of original corner establishment:

Corner not previously established.


DIAGRAM	
T4S R28E	
S22	
W1/16-.-	
S27	
1984	
PLS 848	

Description of corner evidence found:

Corner not previously established.

Description of monument and accessories | established to perpetuate the original location of this corner:

Set 2-1/2"x30" aluminum pipe with 2-1/2" aluminum cap, stamped as shown on the **DIAGRAM**, SET 25" in the ground,
 From Which.
 A Fir 12" dia. Bears N67⁰W., 9.2 ft., scribed: W1/16 S22 BT
 A Fir 8" dia. Bears S60⁰E., 4.5 ft., scribed: W1/16 S27 BT
 Measurements to trees taken with a metal tape and magnetic compass, with Declination set off 20 deg. East.
 Nailed a brass washer stamped PLS 848 on blaze above BT scribe, Bearing Tree Sign above blaze, and warning sign on back of each tree. Fainted a 6" red band at breast ht. around each tree. Set steel fence posts with warning & Boundary Signs, North & East 5 ft. from the corner.

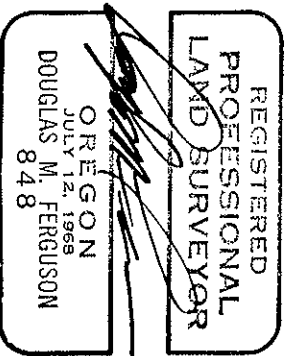

Work by D.M. Ferguson, PLS 848, Mt. Vernon Ore.
 On July 27, 1984
 Witnessed by J. David Brinton, PLS 2065

 State of..... Oregon..... I hereby certify that the within instrument was filed in this office
 for record on the 12th day of..... September..... 1985
David H. Kumbier..... by..... David..... Reynolds
 (COUNTY OFFICIAL)..... (DEPUTY)

Form R6-7100-57 (9/71)



Date 1-16-86

W1/16 MLD

No. 992-R