

CERTIFIED RECORD OF LAND CORNER MONUMENTATION

INDEX No. R-15

History of original corner establishment:

Corner originally established in 1884, by Frank W. Campbell, under General Land Office contract No. 507. Surveyor Generals Notes State: set a basalt stone 16x7x6 ins., 11 ins. in the ground for 1/4 sec. cor. Marked 1/4 on N face, from which.

A tamarrack 12 ins. in diam. bears N 7°E., 27 lks. dist. marked 1/4 S BT

A fir 12 ins. in diam. bears S39°E., 30 lks. dist., marked 1/4 S BT

DIAGRAM	
T4S R28E	
S22	
1/4--	
S27	
1984	
PLS 848	

Description of corner evidence found:


Found 14"x7"x6" stone, set in the ground, with 1/4 on the North face, and recently marked two "X's" on the top.

From which:
A live fir, 24" dia. bears S40°E., 19.5 ft., with blaze healed 10x8" dia. dead & down, with scribing, reads BT; has slid down slope. Also found stump hole which bears approx record to stone.

Description of monument and accessories | established to perpetuate the

original location of this corner: minimum pipe with 2-1/2" aluminum cap, stamped as shown on the **DIAGRAM**, SET 24" in the ground.

From which:
A Fir 12" dia. Bears, N 40°E., 11.2 ft., scribed: 1/4 S22 BT
A Fir 14" dia. Bears, S64°E., 8.7 ft., scribed: 1/4 S27 BT
Measurements to trees taken with a metal tape and magnetic compass, with Declination set off 20 deg. East.
Nailed a brass washer stamped PLS 848 on blaze above BT scribe, Bearing Tree Sign above blaze, and warning sign on back of each tree. Painted a 6" red band at breast ht. around each tree. Set steel fence posts with warning & Boundary Signs, South & West 5 ft. from the corner.

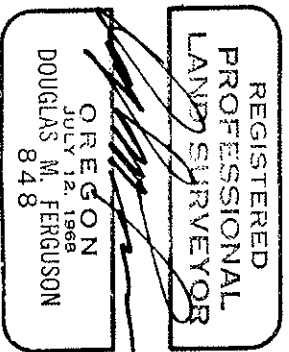

Work by D.M. Ferguson, PLS 848, Mt. Vernon Ore.
On July 30, 1984
Witnessed by J. David Brinton, PLS 2065

16


RECEIVED BY

Form R6-7100-57 (9/71)

Morrow County Surveyor

Date 1-10-86

Rec'd by MLD

No. 076-K