


CERTIFIED RECORD OF LAND CORNER MONUMENTATION

INDEX No. S-15

History of original corner establishment:

Corner not previously established.

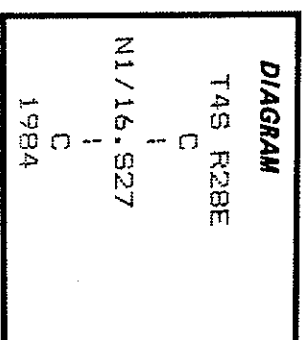

Description of corner evidence found:

Corner not previously established.

Description of monument and accessories | established to perpetuate the original location of this corner:

Set 2-1/2"x30" aluminum pipe with 2-1/2" aluminum cap, stamped as shown on the **DIAGRAM**, SET 14" in the ground, and raised a mound of stone and earth around the pipe.


From Which:

A Pine 12" dia. Bears N 7⁰W., 11.8 ft., scribed: C-N 1/16 S27 BT

A Pine 14" dia. Bears S82⁰E., 19.6 ft., scribed: C-N 1/16 S27 BT

Measurements to trees taken with a metal tape and magnetic compass, with Declination set off 20 deg. East.

Nailed a brass washer stamped PLS 848 on blaze above BT scribe, Bearing Tree Sign above blaze, and warning sign on back of each tree. Painted a 6" red band at breast ht. around each tree. Set steel fence posts with warning & Boundary Signs, North 5 ft. & East 8 ft. from the corner.

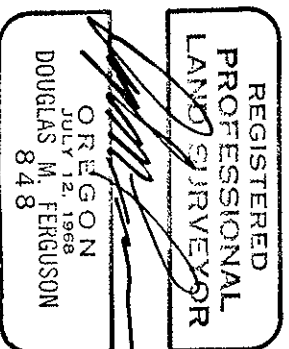

Work by D.M. Ferguson, PLS 848, Mt. Vernon Ore.
 On July 31, 1984
 Witnessed by J. David Brinton, PLS 2065

Office of Subveyor County of MORRIS
 State of Oregon, I hereby certify that the within instrument was filed in this office
 for record on the 14th day of September, 1985 by David H. Krumbein Deputy
 (COUNTY OFFICIAL) (DEPUTY)

Form R6-7100-57 (9/71)

RECEIVED BY
 Morrow County Surveyor

Date 1-10-86
 Rec'd By MLD
 No. 772-K