

CERTIFIED RECORD OF LAND CORNER MONUMENTATION

INDEX No. S-16

History of original corner establishment:

Corner not previously established.


DIAGRAM
T4S R28E
NE 1/16
S27
1984
PLS 848

Description of corner evidence found:

Corner not previously established.

Description of monument and accessories I established to perpetuate the original location of this corner:

Set 2-1/2"x30" aluminum pipe with 2-1/2" aluminum cap, stamped as shown on the **DIAGRAM**, SET 24" in the ground.
 From which.
 A Fine 14" dia. Bears, S50°E 2.3 ft., scribed: NE 1/16 S27 BT
 A Fine 11" dia. Bears, N63°W 26.9 ft., scribed: NE 1/16 S27 BT
 Measurements to trees taken with a metal tape and magnetic compass, with Declination set off 20 deg. East.
 Nailed a brass washer stamped PLS 848 on blaze above BT scribe, Bearing Tree Sign above blaze, and warning sign on back of each tree. Painted a 6" red band at breast ht. around each tree. Set steel fence posts with warning % Boundary Signs, South 5 ft. % West 40 ft. from the corner.

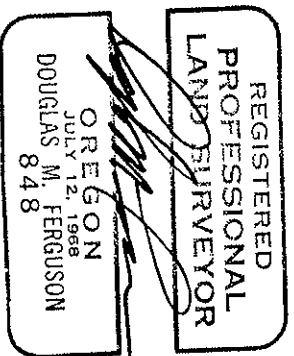

Work by D.M. Ferguson, PLS 848, Mt. Vernon Ore.
 On July 31, 1984
 Witnessed by J. David Brinton, PLS 2065

Office of Superior County of Madras
 State of Oregon hereby certify that the within instrument was filed in this office for record on the 12th day of September, 1984
David H. Kumbert by David H. Kumbert Deborah
 (COUNTY OFFICIAL) (DEPUTY)

Form R6-7100-57 (9/71)

RECEIVED BY
 Morrow County Surveyor

Date 1-10-86
 Rec'd by MLD
 No. 774-K