


CERTIFIED RECORD OF LAND CORNER MONUMENTATION

HISTORY of Original Corner establishment:

Corner originally established in 1884, by Frank W. Campbell, under General Land Office contract No. 507. Surveyor General's Notes State: Set a basalt stone 10x8x6 ins., 7 ins. in the ground for 1/4 sec. cor. marked 1/4 on W face, from which
A fir 8 ins. in diam. bears N29°E., 12 lks. dist. marked 1/4 S BT
A fir 8 ins. in diam. bears N80°W., 10 lks. dist. marked 1/4 S BT

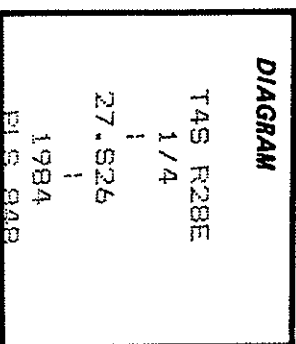

Description of corner evidence found:

Found an old mound of stone, no marks apparently visible on any of the stones.


From which:

Found a root-hole, bears, approx. N80°E., 6 ft. Found a 14" Fir with healed over blazes on N,S & W faces, and a location tag, Dated 4-1-44, Bears N80°E., 9 ft. (not an original bearing tree.) Tags with the same date are found at other corner sites, where original evidence is found, therefore it is believed that this tag is a perpetuation of the original corner. Also this is the same mound of stone, as called for by D.Staabler, on his 1968 survey (Marrow Co. Survey No.204-K) This position is in harmony with surrounding found evidence & fits the call to the Brook, 7 ch. South. Due to the preponderance of evidence, the center of the mound of stone is accepted as the 1/4 corner position.

Description of monument and accessories established to perpetuate the original location of this corner:

Set 2-1/2"x30" aluminum pipe with 2-1/2" aluminum cap, stamped as shown on the **DIAGRAM**, SET 26" in the ground.
From which.

A Fir 16" dia. Bears, S58°W., 35.6 ft., scribed: 1/4 S27 BT
A Fir 16" dia. Bears, N76°E., 9.7 ft., scribed: 1/4 S26 bt
Measurements to trees taken with a metal tape and magnetic compass, with Declination set off 20 deg. East.
Nailed a brass washer stamped PLS 848 on blaze above BT scribe, Bearing Tree Sign above blaze, and warning sign on back of each tree. Painted a 6" red band at breast ht. around each tree. Set steel fence post with warning sign, South 3 ft. from the corner.

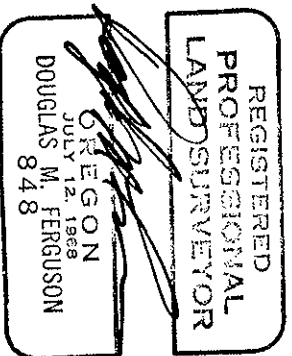

Work by D.M. Ferguson, PLS 848, Mt. Vernon Ore.
On July 31, 1984
Witnessed by J. David Brinton, PLS 2065

Office of..... *Suber*..... County of..... *MARROW*.....
State of *OREGON*..... I hereby certify that the within instrument was filed in this office
for record on the *10th* day of..... *September*....., 19*85*
..... *David D. Kaumbert*..... by..... *B. David Brinton*.....
(COUNTY OFFICIAL) (DEPUTY)

Form R6-7100-57 (9/71)

RECEIVED BY

Marrow County Surveyor

Date 1-10-86

Rec'd by MLO

No. 768-K