


CERTIFIED RECORD OF LAND CORNER MONUMENTATION

INDEX No. T-9

History of original corner establishment:


Corner originally established in 1873, by Zenas F. Moody, under General Land Office Contract No. 184. Surveyor General's Notes State: Set post in earth mound for 1/4 Sec. Cor.

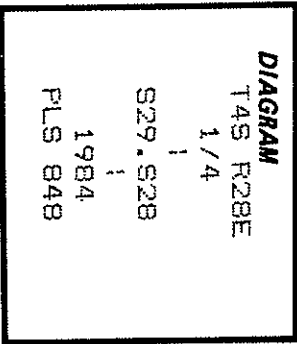

Description of corner evidence found:

After it is determined that this 1/4 Cor. was probably set on an approximate measurement which is stubed south from the Sec. cor. 1/2 mi. north, the search area is revised and the following evidence is recovered. Found a mound of earth with the remains of the original post in the center (pattern of rotten wood, nearly decomposed to earth) from 6" under surface to approx. 18" under surface of mound. No accessories originally established. An old blaze line runs through the corner and extends on the same line south to a point where it intersects the S line of Sec. 28 approx. 680 ft. east from the cor. to sec. 28/29/32/33. Accepted said remains of post as cor. (See map of survey for more information on the distortion Description of monument and accessories established to perpetuate the original location of this corner:

Set 2-1/2"x30" aluminum pipe with 2-1/2" aluminum cap, stamped as shown on the **DIAGRAM**, SET 24" in the ground. From which. A Fir 16" dia. Bears, West, 14.8 ft., scribed: 1/4 S29 BT A Fir 10" dia. Bears, N65E., 13.5 ft., scribed: 1/4 S28 BT Measurements to trees taken with a metal tape and magnetic compass, with Declination set off 20 deg. East. Nailed a brass washer stamped PLS 848 on blaze above BT scribe, Bearing Tree Sign above blaze, and warning sign on back of each tree. Painted a 6" red band at breast ht. around each tree. Set steel fence post with warning sign, North 2 ft. from the corner.

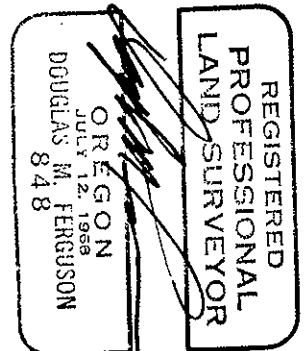

Work by D.M. Ferguson, PLS 848, Mt. Vernon Ore. On Aug. 2, 1984 Witnessed by J. David Brinton, PLS 2065


Form R6-7100-57 (9/71) RECEIVED BY Morrow County Surveyor Date *1-10-86* Rec'd by *MDLD* No *762-K* \* GPO-798-276