


CERTIFIED RECORD OF LAND CORNER MONUMENTATION

INDEX No. U-13

History of original corner establishment:

Corner established in 1968, by Donald L. Staebler. His map of survey, Morrow County Survey No. 204-K shows: At mid point between Cor. Sec. 27, 28, 33 & 34 and the 1/4 cor. Sec. 28/27, set an iron pin.

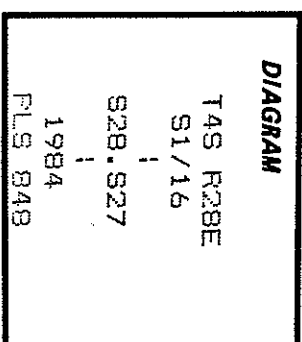

Description of corner evidence found:

Found a 5/8" iron pin with a steel post set alongside.

No accessories originally established.


Since the pin conforms reasonably well with record measurements from Staebler survey it is accepted as the 1/16 corner position.

Description of monument and accessories | established to perpetuate the original location of this corner:

Set 2-1/2"x30" aluminum pipe with 2-1/2" aluminum cap, stamped as shown on the **DIAGRAM**, SET 25" in the ground, & set original 5/8" iron pin alongside.

From which:

A Spruce 20" dia. Bears, S25°W., 13.4 ft., scribed: S1/16 S28 BT
A Spruce 8" dia. Bears, N1°E., 13.0 ft., scribed: S1/16 S27 BT
Measurements to trees taken with a metal tape and magnetic compass, with Declination set off 20 deg. East.
Nailed a brass washer stamped PLS 848 on blaze above BT scribe, Bearing Tree Sign above blaze, and warning sign on back of each tree. Painted a 6" red band at breast ht. around each tree. Set steel fence posts with warning & Boundary Signs, South & East 4 ft. from the corner.
Reset the steel post as found, alongside monument, and attached a warning sig

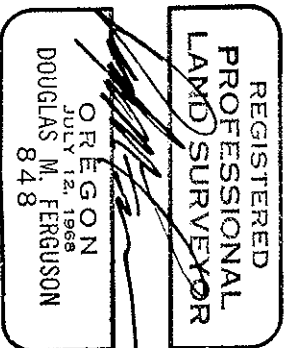

Work by D.M. Ferguson, PLS 848, Mt. Vernon Ore.
On Aug. 1, 1984
Witnessed by J. David Brinton, PLS 2065

Office of..... SURVEYOR..... County of..... MORROW.....
State of..... OREGON..... I hereby certify that the within instrument was filed in this office
for record on the 10th day of..... September..... 1985
..... David H. Keunbein..... by..... Barrett Raymond.....
(COUNTY OFFICIAL) (DEPUTY)

RECEIVED BY
MORROW COUNTY SURVEYOR
Date 1-10-86
Made by POLD
No. 787-R

Form R6-7100-57 (9/71)