


CERTIFIED RECORD OF LAND CORNER MONUMENTATION

INDEX No. U-15

History of original corner establishment:

Corner was established in 1968, by Donald L. Staebler. See Morrow Co. Surveyor Records, Map No. 204-K, that map shows: "set iron pin"

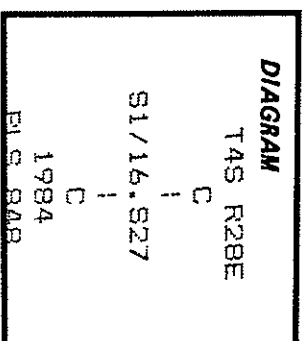

Description of corner evidence found:

Found a 5/8" iron pin, which bears S 7° 13' 23"W., 77.10 ft. from 1/16 cor'.

No accessories established by Staebler, in 1968. Since the pin does not conform to the proper position by this large amount, it is not accepted as the true corner. The 1/16 Corner is established at midpoint between the C1/4 and the S1/4 corners of this section.

Description of monument and accessories I established to perpetuate the original location of this corner:


Set 2-1/2"x30" aluminum pipe with 2-1/2" aluminum cap, stamped as shown on the **DIAGRAM**, SET 27" in the ground.

From which.

A Fir 14" dia. Bears, N18° 3.0 ft., scribed: C-S 1/16 S27 BT
A Spurce 7" dia. Bears, S12° 10.6 ft., scribed: C-S 1/16 S27 BT

Measurements to trees taken with a metal tape and magnetic compass, with Declination set off 20 deg. East.

Nailed a brass washer stamped PLS 848 on blaze above RT scribe, Bearing Tree Sign above blaze, and warning sign on back of each tree. Painted a 6" red band at breast ht. around each tree. Set steel fence posts with warning & Boundary Signs, East & West 5 ft. from the corner.

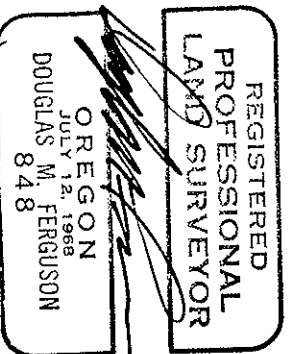

Work by D.M. Ferguson, PLS 848, Mt. Vernon Ore.
On Aug. 1, 1984
Witnessed by J. David Brinton, PLS 2065

Office of SURVEYOR County of MORROW
State of OREGON I hereby certify that the within instrument was filed in this office
for record on the 10th day of September 1985
David H. Krumboltz by Brent Rayfield
(COUNTY OFFICIAL) (DEPUTY)

RECEIVED BY

Form R6-7100-57 (9/71)

Morrow County Surveyor

*GPO-798-276

Date 1-12-86
Filed by MJD
No. 780-K