

CERTIFIED RECORD OF LAND CORNER MONUMENTATION


INDEX No. U-16

History of original corner establishment:
Corner not previously established.

DIAGRAM
PLS R28E
SE 1/16
S27
1984
PLS 848

Description of corner evidence found:
Corner not previously established.

Description of monument and accessories | established to perpetuate the original location of this corner:
Set 2-1/2"x30" aluminum pipe with 2-1/2" aluminum cap, stamped as shown on the DIAGRAM, SET 20" in the ground.
From which.
A Pine 14" dia. Bears, S 8⁰W., 42.1 ft.; scribed: SE 1/16 S27 BT
A Fir 14" dia. Bears, N43⁰W., 10.2 ft.; scribed: SE 1/16 S27 bt
Measurements to trees taken with a metal tape and magnetic compass, with Declination set off 20 deg. East.
Nailed a brass washer stamped PLS 848 on blaze above BT scribe, Bearing Tree Sign above blaze, and warning sign on back of each tree. Painted a 6" red band at breast ht. around each tree. Set steel fence posts with warning & Boundary Signs, North 20 ft. & West 5 ft. from the corner.

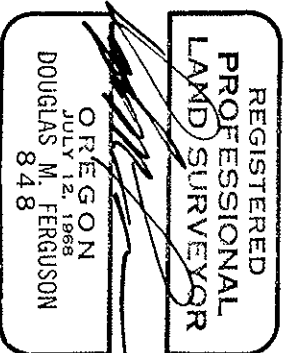

Work by D.M. Ferguson, PLS 848, Mt. Vernon Ore
On July 31, 1984
Witnessed by J. David Brinton, PLS 2065

12

Office of..... SURVEYOR..... County of..... MARION.....
State of..... Oregon..... I hereby certify that the within instrument was filed in this office
for record on the 12th day of..... September....., 1985
..... David H. Krimbein..... by..... Brent Reynolds.....
(COUNTY OFFICIAL) (DEPUTY)

RECEIVED BY

Marion County Surveyor
Date 1-10-86

Included PLOD
No. 984-R