


CERTIFIED RECORD OF LAND CORNER MONUMENTATION

INDEX No. V-12
History of original corner establishment:

Corner not previously established.

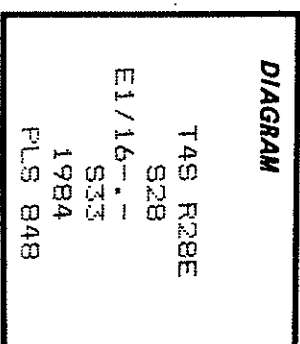


Description of corner evidence found:

Corner not previously established.

Description of monument and accessories I established to perpetuate the original location of this corner:

Set 2-1/2"x30" aluminum pipe with 2-1/2" aluminum cap, stamped as shown on the **DIAGRAM**, SET 28" in the ground.
 From which:
 A Fir 18" dia. Bears, N37⁰W., 17.0 ft., scribed: E1/16 S28 BT
 A Spruce 10" dia. Bears, S15⁰E., 15.6 ft., scribed: E1/16 S33 BT
 Measurements to trees taken with a metal tape and magnetic compass, with Declination set off 20 deg. East.
 Nailed a brass washer stamped PLS 848 on blaze above BT scribe, Bearing Tree Sign above blaze, and warning sign on back of each tree. Painted a 6" red band at breast ht. around each tree. Set steel fence post with warning & Boundary Signs, East 5 ft. from the corner.

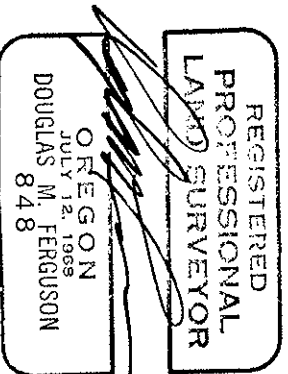

Work by D.M. Ferguson, PLS 848, Mt. Vernon Ore.
 On Aug. 2, 1984
 Witnessed by J. David Brinton, PLS 2065

Office of..... SURVEYOR..... County of MORROW.....
 State of OREGON..... I hereby certify that the within instrument was filed in this office
 for record on the 11th day of September, 1985
David H. Kumbain by David Brinton
 (COUNTY OFFICIAL) (DEPUTY)

RECEIVED BY

Form R6-7100-57 (9/71)

Morrow County Surveyor

Date 1-10-86

Rec'd by MID

No. 005-R