

CERTIFIED RECORD OF LAND CORNER MONUMENTATION

INDEX No. V-15

History of original corner establishment:

Corner originally established in 1884, by Frank W. Campbell, under General Land Office contract No. 507. Surveyor General's Notes State: Set a Granite stone 14x10x4 ins., 9 ins. in the ground, for 1/4 sec. cor. Marked 1/4 on N face.

From Which:

A Pine 12 ins. in diam. bears, N28°E., 49 lks dist. marked 1/4 S BT
A Pine 24 ins. in diam. bears, S44°W., 42 lks dist. marked 1/4 S BT

DIAGRAM	
T4S R28E	
S27	
1/4--	
S34	
1984	
PLS 848	

Description of corner evidence found:

Found 14"x8"x4" Granite stone, no marks apparently visible, lying loose on a mound of stone.

From Which:

Found a Pine, 20" dia., live, with blaze healed over, bears, N28E., 34.1 ft., (Record N28E., 32.3 ft.)
Found a Pine, 36" dia., live, with blaze healed over, bears, S44W., 28.2 ft. (Record S44W., 27.7 ft.)
Since the bearing trees closely conform to record measurement to the center of the stone mound, the said center is accepted as the 1/4 Cor. Position.


Description of monument and accessories | established to perpetuate the original location of this corner:

Set 2-1/2"x30" aluminum pipe with 2-1/2" aluminum cap, stamped as shown on the **DIAGRAM**, SET 15" in the ground, and raised a mound of stone around the pipe.

From Which:

Rescribed original bearing tree, Bears, N28°E., 34.1 ft., scribed: 1/4 S27 B
Rescribed original bearing tree, Bears, S44°W., 28.2 ft., scribed: 1/4 S34 B
Measurements to trees taken with a metal tape and magnetic compass, with Declination set off 20 deg. East.

Nailed a brass washer stamped PLS 848 on blaze above BT scribe, Bearing Tree Sign above blaze, and warning sign on back of each tree. Painted a 6" red band at breast ht. around each tree. Set steel fence post with warning Sign, North 5 ft. from the corner.

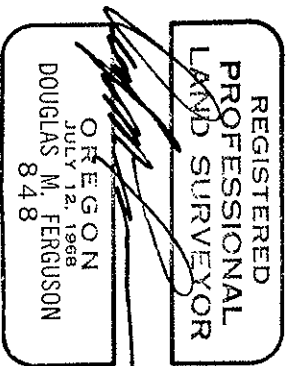

Work by D.M. Ferguson, PLS 848, Mt. Vernon Ore.
On Aug. 16, 1984
Witnessed by J. David Brinton, PLS 2065

State of..... Oregon I hereby certify that the within instrument was filed in this office
for record on the 11th day of..... September....., 1984
..... David H. Krumbein..... by..... Samuel Reynolds.....
(COUNTY OFFICIAL) (DEPUTY)

RECEIVED BY

Worrow County Surveyor
Date 1-10-86
MLD
No. 786-K