


CERTIFIED RECORD OF LAND CORNER MONUMENTATION

INDEX No. V-17

History of original corner establishment:

Corner originally established in 1884, by Frank W. Campbell, under General Land Office Contract No. 507. Surveyor General's Notes State: Set a post 4 ft. long, 4 ins. square, 24 ins. in the ground, for cor. to Sacs. 26, 27, 34 & 35, marked, T4S S26, on NE, R28E S35 on SE, S34 on SW, and S27 on NW faces, with 1 notch on S and 2 notches on East edges.

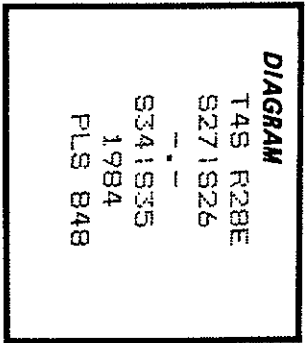

from which
A fir 6 ins. in diam. bears N82°E., 42 lks. dist. marked T4S R28E S26 BT
A fir 8 ins. in diam. bears S45°E., 52 lks. dist. marked T4S R28E S35 BT
A fir 12 ins. in diam. bears S21°W., 73 lks. dist. marked T4S R28E S34 BT
A fir 6 ins. in diam. bears N67°W., 51 lks. dist. marked T4S R28E S27 BT


Description of corner evidence found:

No evidence of original post remaining.

Found 12"x2"x1" remains of rotten wood with scribing clearly visible, but not legible, lying in rotten wood alongside a 6" fir that has grown out of the remains of the original bearing tree. When a point is set at S62W., 27.7 ft. (Record S82°W 27.7 ft.) from the Sec. 26 BT, the following evidence is found:
A root hole bears, approx. S45°E., 34 ft. (S35 BT)
A root hole and rotten wood bears approx. S15°W, 48 ft. (S34BT)
A root hole and rotten wood bears approx. N68°W, 34 ft. (S27BT)
Since the above combination most nearly conforms to Record measurements, the above described point is accepted as the Sec. Corner.
from scribed remains) is accepted as the Sec. Corner.

Description of monument and accessories established to perpetuate the original location of this corner:

Set 2-1/2"x3/32" aluminum pipe with 2-1/2" aluminum cap, stamped as shown on the DIAGRAM, SET 24" in the ground.
From which.
A Pine 12" dia. Bears, N17° 14.0 ft., scribed: T4S R28E S27 BT
A Fir 12" dia. Bears, N20° 16.9 ft., scribed: T4S R28E S26 BT
A Fir 12" dia. Bears, S80° 12.4 ft., scribed: T4S R28E S35 BT
A Fir 10" dia. Bears, S65° 8.4 ft., scribed: T4S R28E S34 BT
Measurements to trees taken with a metal tape and magnetic compass, with Declination set off 20 deg. East.
Nailed a brass washer stamped PLS 848 on blaze above BT scribe, Bearing Tree Sign above blaze, and warning sign on back of each tree. Painted a 6" red band at breast ht. around each tree. Set steel fence post with warning Sign, South 1 ft. from the corner.

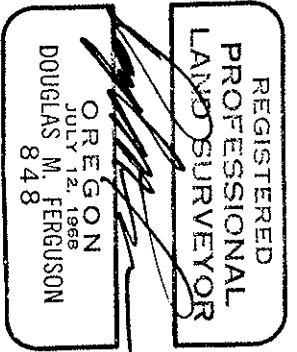

Work by D.M. Ferguson, PLS 848, Mt. Vernon Ore.
On July 31, 1984
Witnessed by J. David Brinton, PLS 2065

Office of..... Surrogate..... County of Morrow.....
State of Oregon..... I hereby certify that the within instrument was filed in this office
for record on the 12th day of September, 1985
David H. Kumbain by SSneat Rayne
(COUNTY OFFICIAL) (DEPUTY)

RECEIVED BY
Morrow County Surveyor
Date 1-10-86
by MLD
No. 782-K