

CERTIFIED RECORD OF LAND CORNER MONUMENTATION

INDEX No. Y-23

History of original corner establishment:

Corner originally established in 1884, by Frank W. Campbell, under General Land Office Contract No. 507. Surveyor General's Notes State: Set a basalt stone 10x10x7 ins., 7 ins. in the ground for 1/4 sec. cor., marked, 1/4 on N face.

from which

A fir 20 ins. in dia. bears N49°W., 22 lks. dist. marked, 1/4 S BT

A fir 16 ins. in dia. bears S 2°E., 19 lks. dist. marked, 1/4 S BT

DIAGRAM
T45 R28E
S25
1/4--
1884
PLS 848

Description of corner evidence found:

Found a 10"x10"x8" stone, lying loose, with marks visible, but not legible, lying westerly downhill 5 ft. from corner position as determined at record measurement from the original Bearing Trees.

Found a Fir 32" dia., live, with double blaze healed over, Bears Record N49°W., 14.5 ft., from a point. Found a Fir 30" dia., live, with double blaze healed over, Bears Record S 2°E., 12.5 ft., from a point. Accepted this said point as the 1/4 corner position.

Description of monument and accessories I established to perpetuate the original location of this corner:

Set 2-1/2"x30" aluminum pipe with 2-1/2" aluminum cap, stamped as shown on the DIAGRAM, SET 25" in the ground and set original stone North alongside the pipe.

From which:


A Fir 10" dia., Bears, 886°W., 18.4 ft., scribed: 1/4 S36 BT

A Fir 7" dia., Bears, N 7°E., 33.9 ft., scribed: 1/4 S25 BT

Measurements to trees taken with a metal tape and magnetic compass,

with Declination set off 20 deg. East.

Nailed a brass washer stamped PLS 848 on blaze above BT scribe, Bearing Tree Sign above blaze, and warning sign on back of each tree. Painted a 6" red band at breast ht. around each tree. Set steel fence post with warning sign, alongside corner monument.

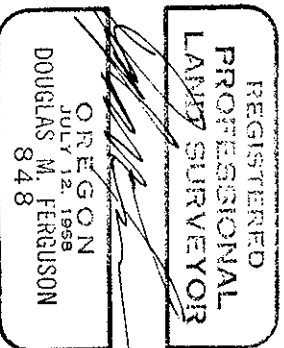

Work by D.M. Ferguson, PLS 848, Mt. Vernon Ore
On July 23, 1984
Witnessed by J. David Brinton, PLS 2065

State of Oregon I hereby certify that the within instrument was filed in this office
for record on the 10th day of September, 1985
by David H. Krumbein County Official
David H. Krumbein Deputy
(COUNTY OFFICIAL) (DEPUTY)

Form R6-7100-57 (9/71)

1-10-86
MID
752-R